



# CONSTRUCTION LAYOUT DRAWING

1 of 2

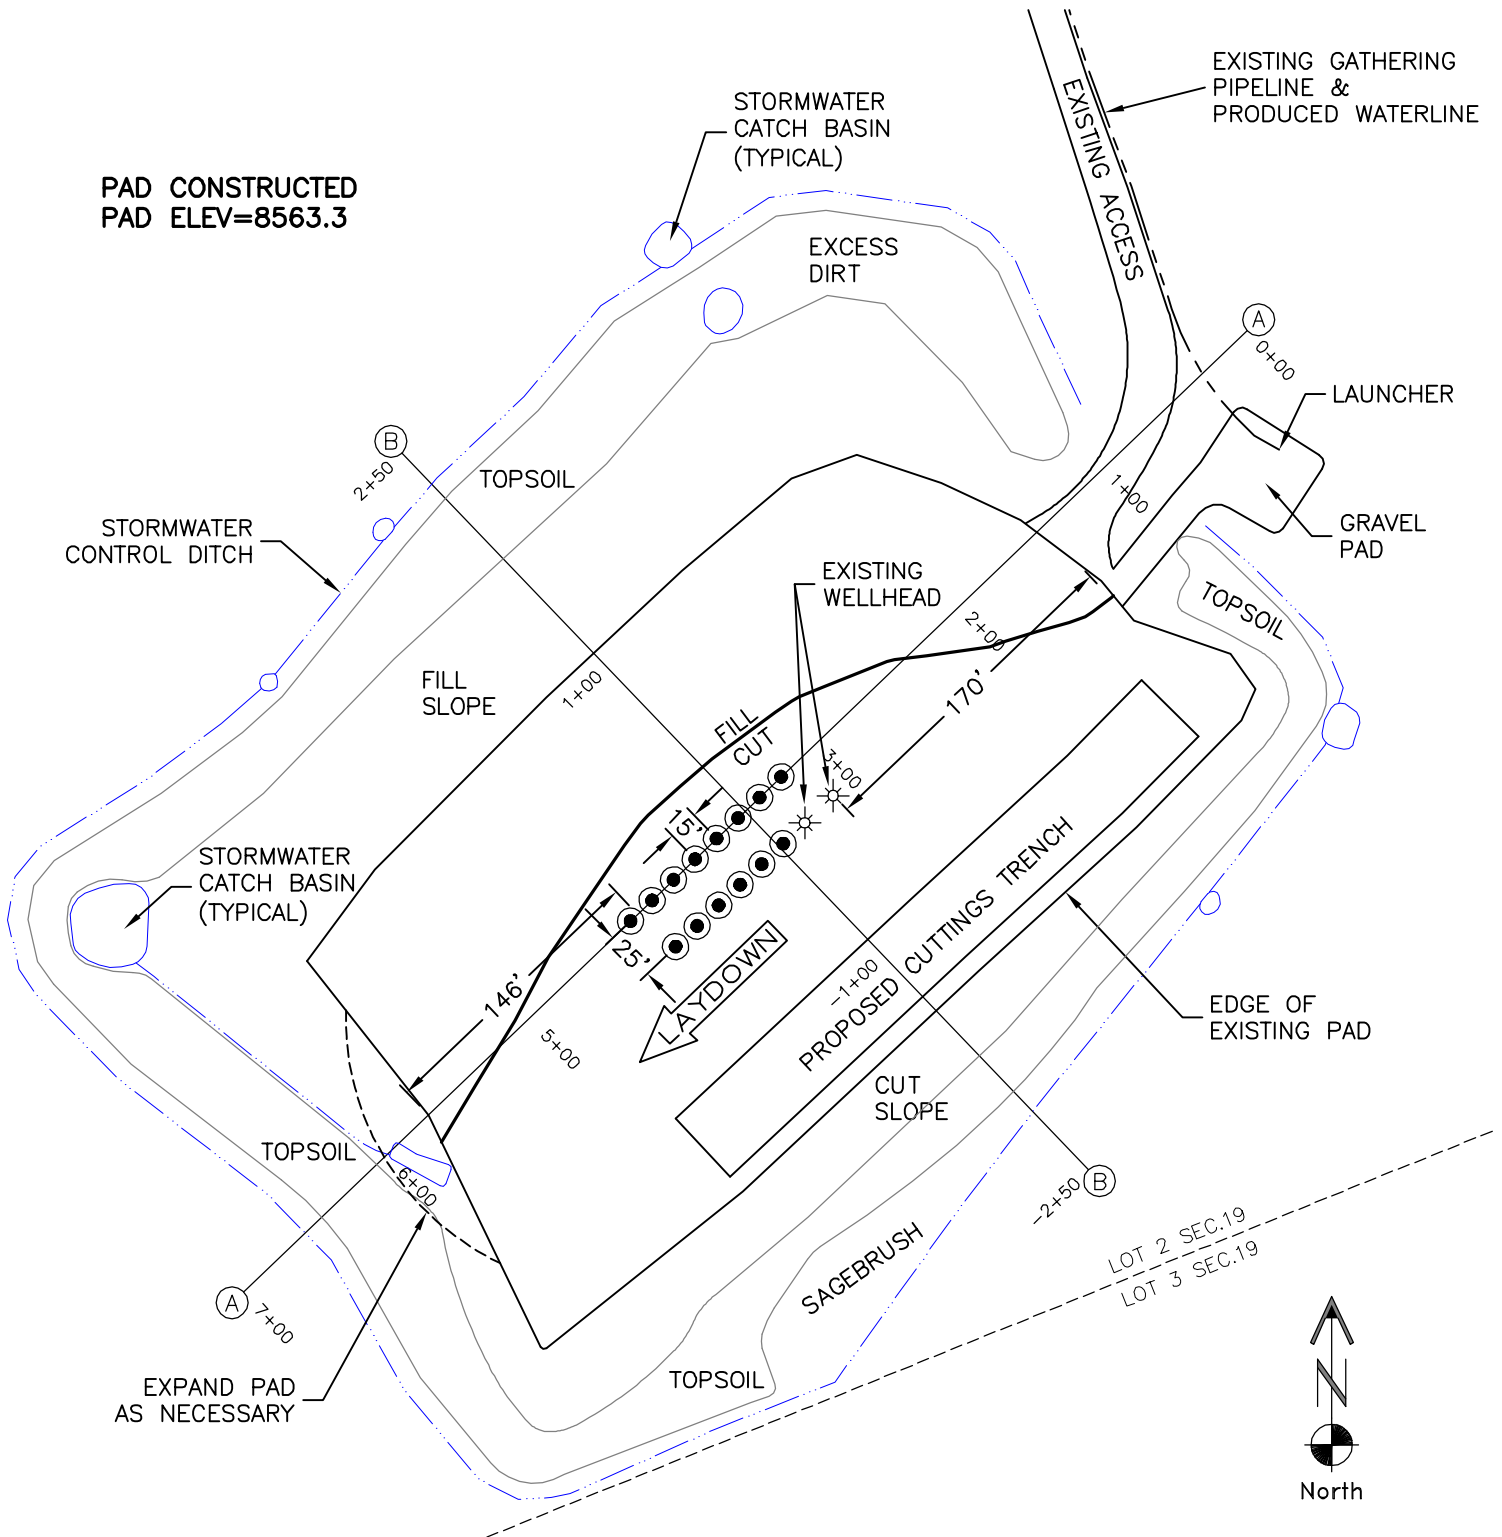

## WELL LAYOUT

- |        |   |        |   |
|--------|---|--------|---|
| 19-04A | ● | 19-05B | ☼ |
| 19-04B | ● | 24-01C | ☼ |
| 19-04C | ● | 19-05A | ● |
| 19-04D | ● | 19-05C | ● |
| 24-01A | ● | 24-08B | ● |
| 24-01B | ● | 19-05D | ● |
| 24-01D | ● | 24-08C | ● |
| 24-08A | ● | 24-09C | ● |
- LAYDOWN

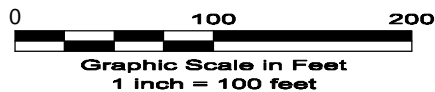

7/23/10

## NOTES:

1) CUTTINGS TRENCH LOCATION & SIZE TO BE DETERMINED AT TIME OF CONSTRUCTION.

**GEO SURV**



LAND SURVEYING AND MAPPING  
LAFAYETTE - WINTER PARK  
Ph 303 666 0379 Fx 303 665 6320

**LARAMIE ENERGY II LLC**  
**HONEA 19-05 PAD**

**GOVT LOT 2 SEC. 19 T7S R93W**  
**6th PM GARFIELD COUNTY COLORADO**

# CONSTRUCTION LAYOUT DRAWING

2 of 2

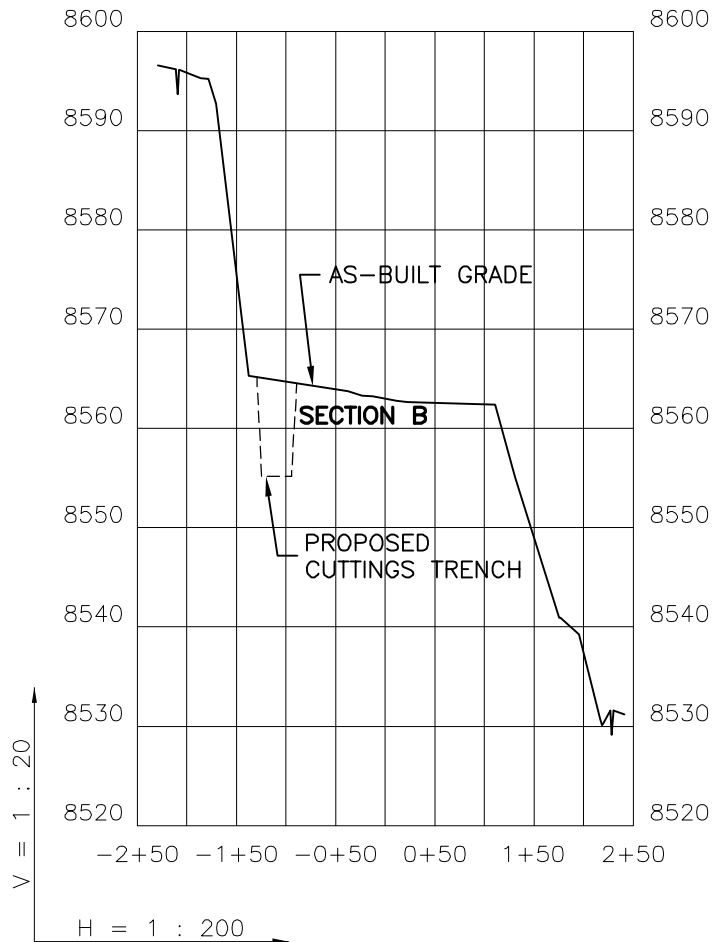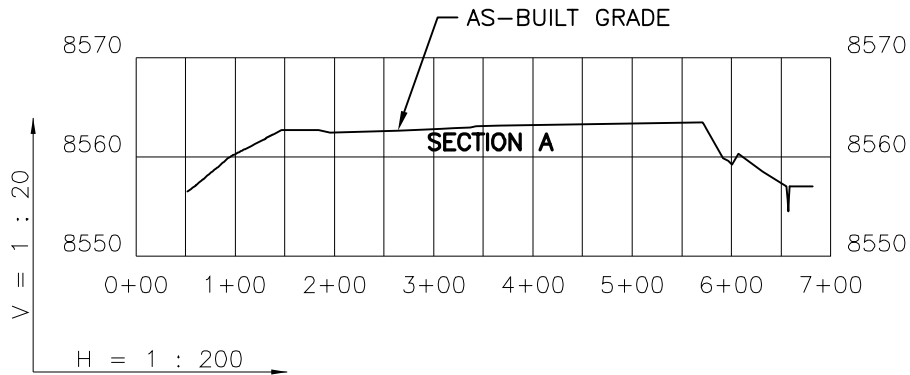

7/23/10

**LAND SURVEYING AND MAPPING**  
**LAFAYETTE - WINTER PARK**  
 Ph 303 666 0379 Fx 303 665 6320

**LARAMIE ENERGY II LLC**  
**HONEA 19-05 PAD**

**GOVT LOT 2 SEC. 19 T7S R93W**  
**6th PM GARFIELD COUNTY COLORADO**