


WELL LOCATION CERTIFICATE

SECTION 25, TOWNSHIP 3 NORTH, RANGE 64 WEST, 6TH P.M.

NOTES:

WELL FALLS IN AN OPEN FIELD.
 THIS IS A DIRECTIONAL DRILL WELL.
 BOTTOM HOLE IS AT 1984' FSL, 1976' FEL.
 SEE LOCATION DRAWING FOR IMPROVEMENTS.


GROUND ELEVATION = 4790'
 LAT. & LONG. = N 40.19115°
 W 104.49528°

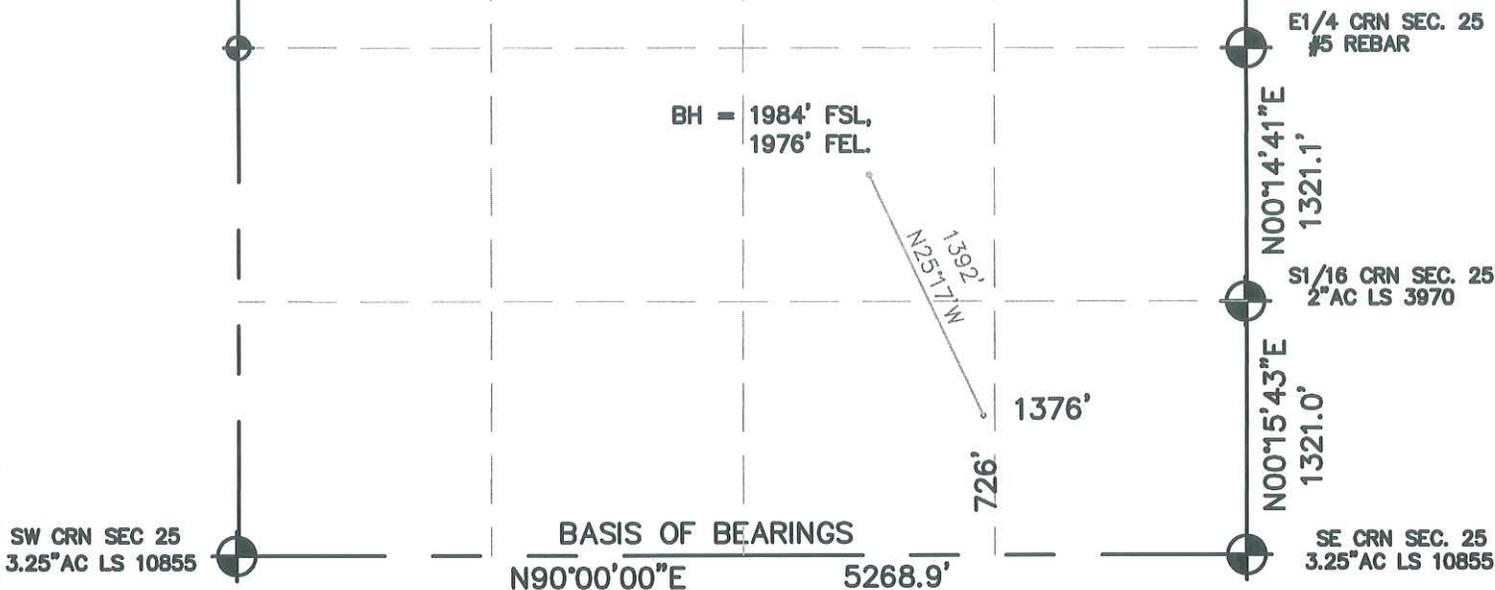

I HEREBY STATE TO PETROLEUM DEVELOPMENT CORP. THAT THIS WELL LOCATION CERTIFICATE FOR THE WELL COORS ENERGY 33-25D IS LOCATED 726' FSL & 1376' FEL, SEC. 25, T3N, R64W, 6PM.

LEGEND

- = FOUND MONUMENT
- = PROPOSED WELL
- = BOTTOM HOLE

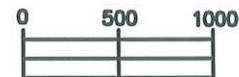

SCALE 1" = 1000'

ELEVATION SOURCE = USGS 7.5' QUAD.MAP CONTOURS NGVD 1929 DATUM.

LAT. & LONG. ARE DIFFERENTIALLY CORRECTED (NAD'83) USING (DGPS) WITH (PDOP) VALUES LESS THAN SIX (6).

SHOWN DISTANCES ARE FIELD MEASURED - EXTERIOR SECTION LINES ARE DRAWN TO SCALE (BEST APPROX. OR FOUND MONUMENT).

THOMAS G. CARLSON, PLS 24657
 HORSESHOE SURVEYING, LLC

THIS IS NOT A MONUMENTED BOUNDARY SURVEY, IT IS ONLY A DRAWING INTENDED TO DEPICT THE WELL LOCATION TO SECTION LINES.

DISTANCES TO WELL SHOWN PERPENDICULAR TO SECTION LINES.

PREPARED BY: HORSESHOE SURVEYING, LLC PO BOX 150458 LAKEWOOD, CO 80215 (720)872-0196		WELL NAME: COORS ENERGY 33-25D	
DRAWING DATE: 2-17-10		LOCATION: WELD COUNTY, CO SE1/4, SEC. 25, T3N, R64W, 6TH P.M.	
FIELD DATE: 2-17-10	BY: TGC	CHKD:	JOB NO.
		SHEET NO. 1 OF 1	

