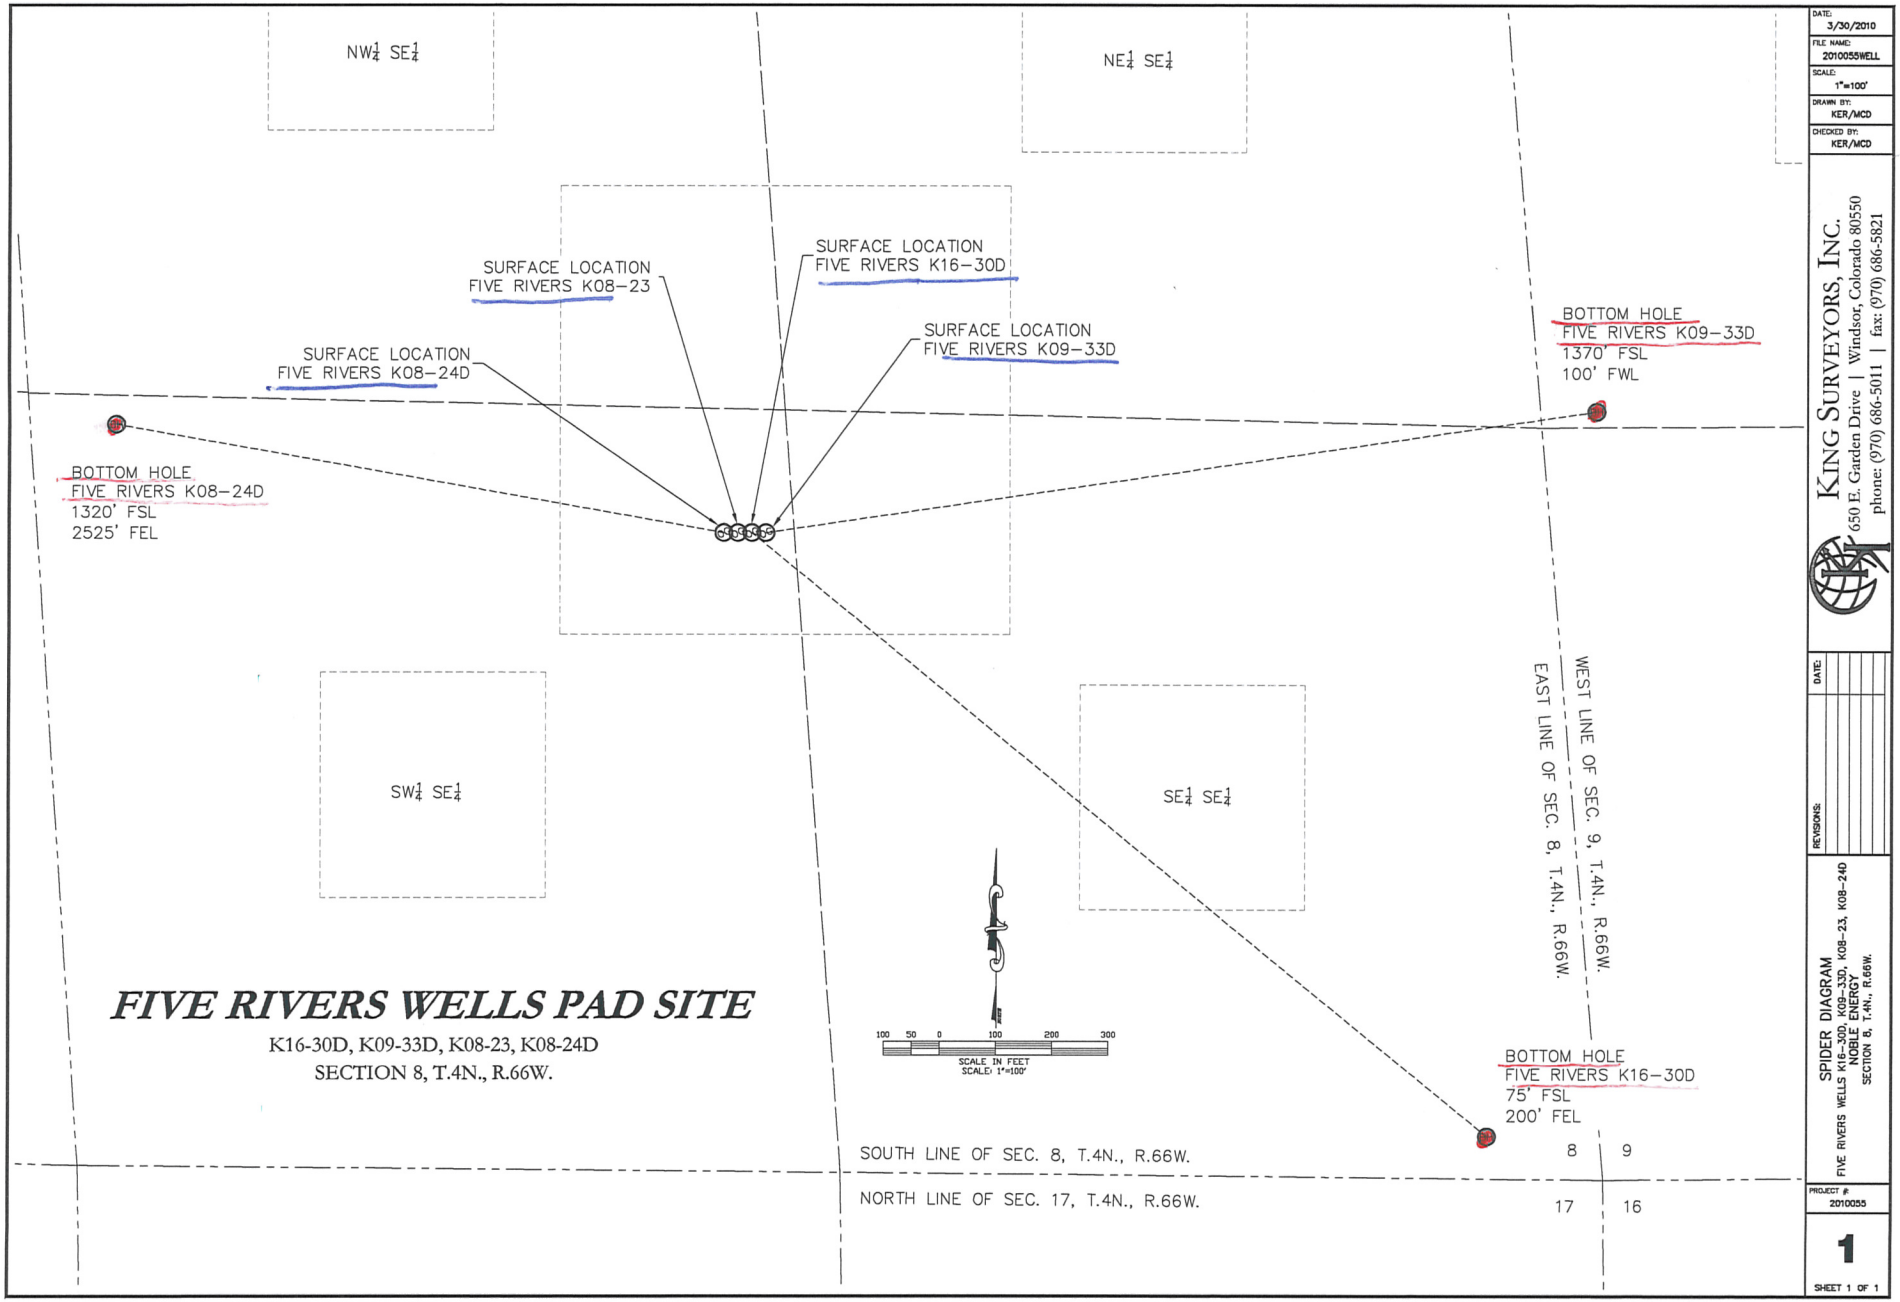

FIVE RIVERS WELLS PAD SITE

K16-30D, K09-33D, K08-23, K08-24D
SECTION 8, T.4N., R.66W.

DATE: 3/30/2010
FILE NAME: 2010055WELL
SCALE: 1"=100'
DRAWN BY: KER/MCD
CHECKED BY: KER/MCD

KING SURVEYORS, INC.
650 E. Garden Drive | Windsor, Colorado 80550
phone: (970) 686-5011 | fax: (970) 686-5821

DATE:
REVISIONS:

SPIDER DIAGRAM
FIVE RIVERS WELLS K16-30D, K09-33D, K08-23, K08-24D
NOBLE ENERGY
SECTION 8, T.4N., R.66W.

PROJECT #: 2010055

1

SHEET 1 OF 1

