
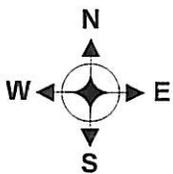


WCR 89

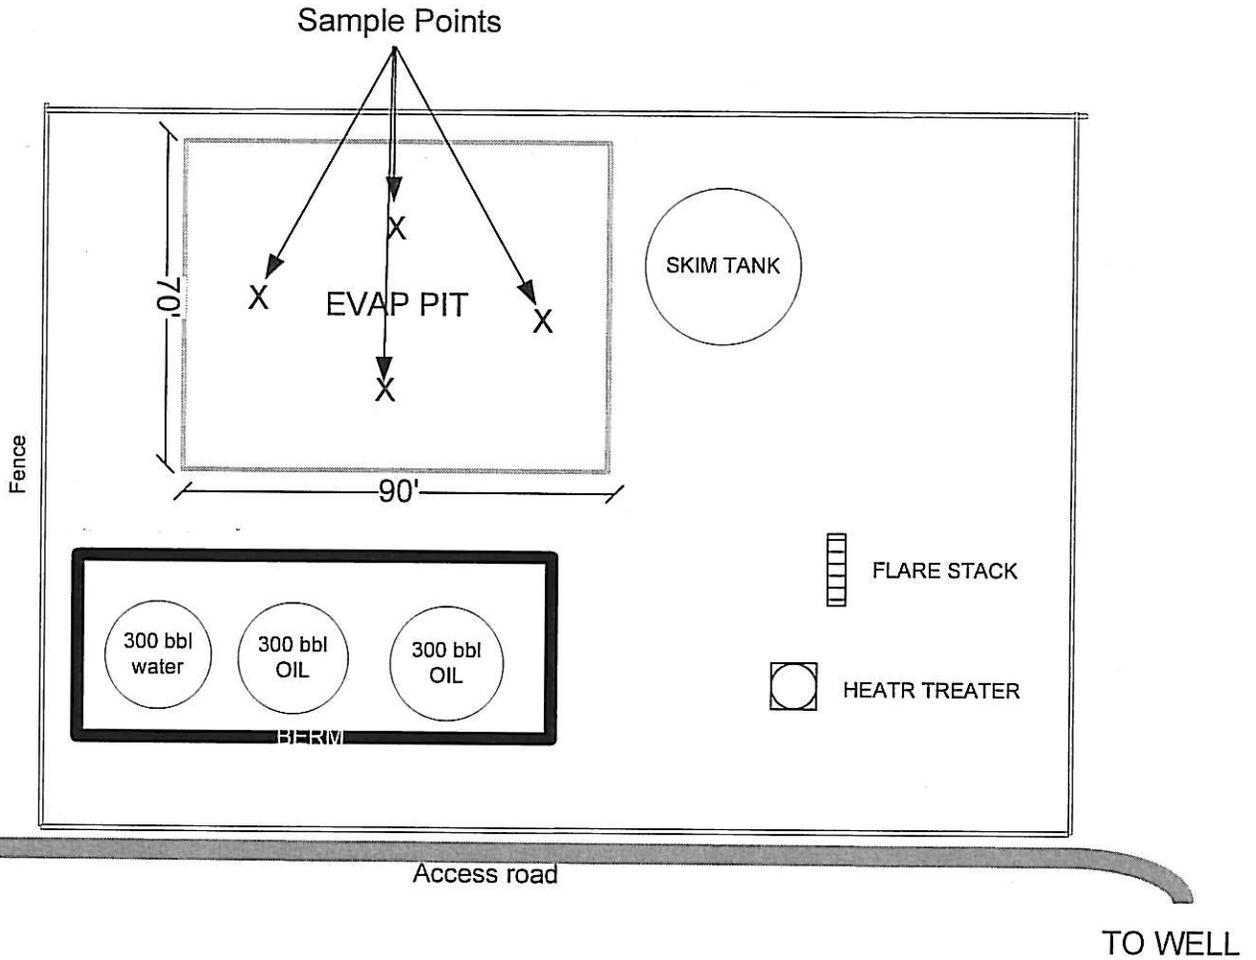

noble energy

Ray State 13-16

NOT TO SCALE