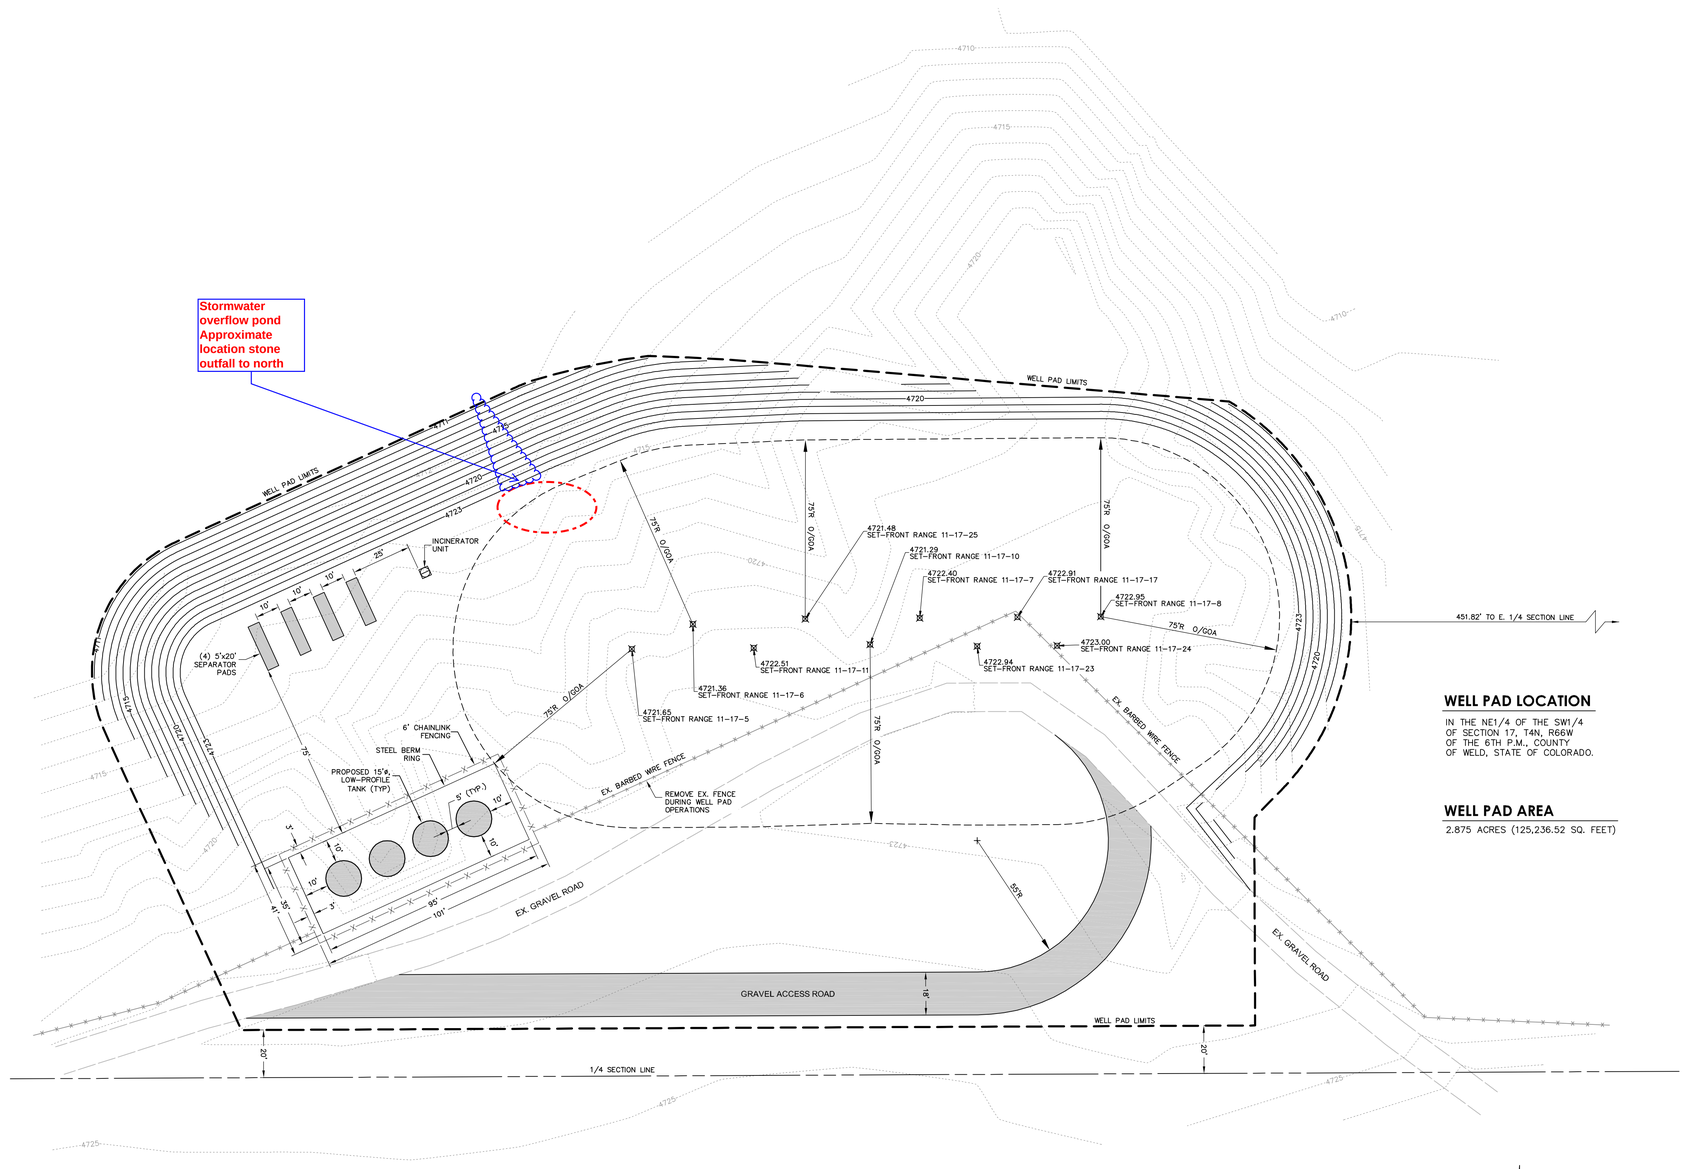

WELL PAD LOCATION

IN THE NE1/4 OF THE SW1/4 OF SECTION 17, T4N, R66W OF THE 6TH P.M., COUNTY OF WELD, STATE OF COLORADO.

WELL PAD AREA

2.875 ACRES (125,236.52 SQ. FEET)

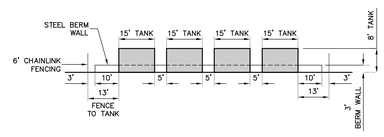

TANK AREA CROSS-SECTION

SCALE: 1"=30'

30' 0 30' 60'

ORIGINAL SCALE: 1" = 30'

REVISIONS

NO.	DESCRIPTION	DATE	BY

ENGINEERING :: 1860 Lefthand Circle, Suite A
PLANNING :: Longmont, CO 80501
SURVEYING :: P 303.682.1131
F 303.682.1149

CIVILARTS

KPK
K.P. KAUFMANN COMPANY, INC.

FRONT RANGE 11-17-SERIES

CONCEPTUAL WELL PAD LAYOUT

DATE:	5.18.2010
DRAWN BY:	CM
CHECKED BY:	PB
JOB NO:	597-7

EX-A

1 OF 1

Z:\597-7_dd-597-7\dwg\597-7-Well Pads\597-7-WELL-PADS.dwg, Well Pad Plan, 5/18/2010 2:10:58 PM, McCary