


WELL LOCATION CERTIFICATE

SECTION 2, TOWNSHIP 6 NORTH, RANGE 66 WEST, 6TH P.M.

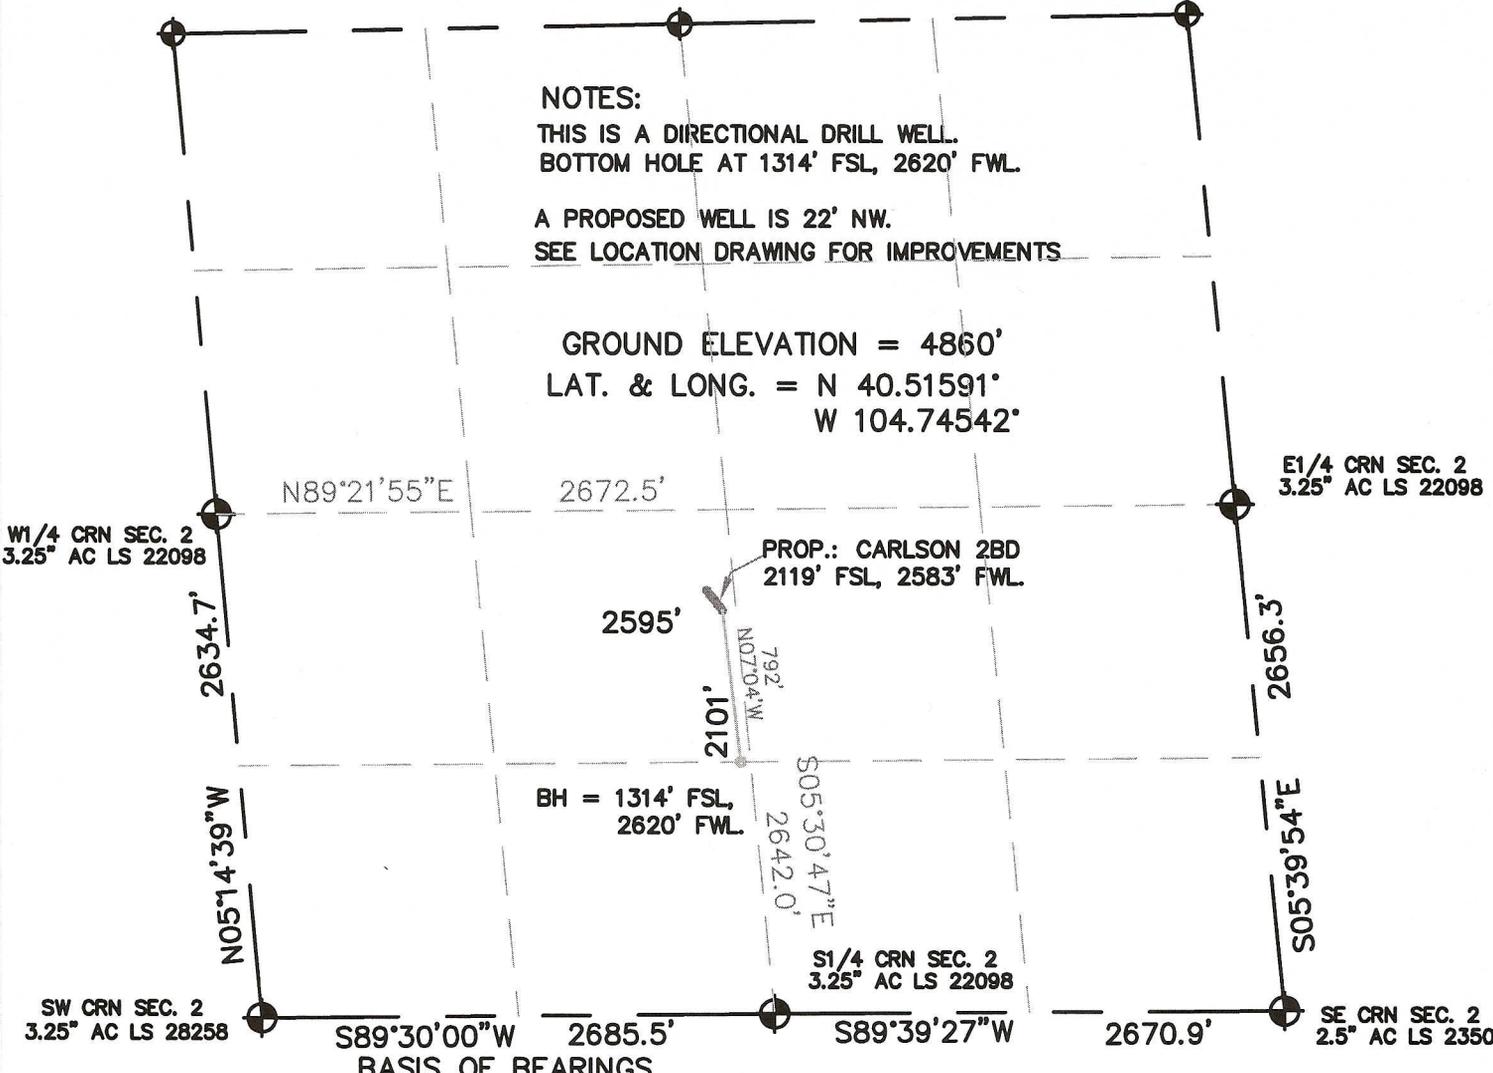

I HEREBY STATE TO PERTOLEUM DEV. CORP. THAT THIS WELL LOCATION CERTIFICATE FOR THE WELL CARLSON 2PD IS LOCATED 2101' FSL & 2595' FWL, SEC. 2, T6N, R66W, 6PM.



LEGEND

- = FOUND MONUMENT
- = PROPOSED WELL
- = BOTTOM HOLE

NORTH

0 500 1000

SCALE 1" = 1000'

ELEVATION SOURCE = USGS 7.5' QUAD.MAP CONTOURS NGVD 1929 DATUM.

THOMAS G. CARLSON, PLS 24657
 HORSESHOE SURVEYING, LLC

THIS IS NOT A MONUMENTED BOUNDARY SURVEY, IT IS ONLY A DRAWING INTENDED TO DEPICT THE WELL LOCATION TO SECTION LINES.

SHOWN DISTANCES ARE FIELD MEASURED - EXTERIOR SECTION LINES ARE DRAWN TO SCALE (BEST APPROX. OR FOUND MONUMENT). DISTANCES TO WELL SHOWN PERPENDICULAR TO SECTION LINES.

PREPARED BY: HORSESHOE SURVEYING, LLC PO BOX 150458 LAKEWOOD, CO 80215 (720)872-0196		WELL NAME: CARLSON 2PD	
DRAWING DATE: 6-17-10		LOCATION: WELD COUNTY, CO SW1/4, SEC. 2, T6N, R66W, 6TH P.M.	
FIELD DATE: 6-16-10	BY: TGC	CHKD:	JOB NO. SHEET NO. 1 OF 1