


R 98 W

N

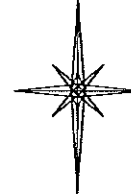

SCALE 1" = 1000'

T 2 S

LATITUDE (NAD 83)
NORTH 39.910260 DEG.
LONGITUDE (NAD 83)
WEST 108.335159 DEG.
NORTHING (NAD 83)
1768857.35
EASTING (NAD 83)
2204755.20

BASIS OF ELEVATION: NORTH 1/4
CORNER SECTION 1, T 2 S, R 98 W,
ELEVATION = 6616.23'

LEGEND

- ◆ WELL LOCATION
- ▲ PREVIOUSLY FOUND MONUMENT
- L DENOTES 90° TIE
- CALCULATED CORNER
- APPROXIMATE BHL



SCALE FEET

BASIS OF BEARING/DATUM

ALL BEARINGS ARE GRID BEARINGS OF THE SPCS CO, NORTH ZONE, NAD 27. THE BASIS OF GRID BEARING IS THE NORTH LINE OF THE NE 1/4 OF SEC. 1, BEING MONUMENTED WITH GLO BC'S. THAT BEARING BEING S 87°56'19" E


SURVEYOR'S STATEMENT

I, RICHARD A. BULLEN JR., AN EMPLOYEE AND AGENT ON BEHALF OF D.R. GRIFFIN & ASSOCIATES, INC. STATE THE PLAT HEREON IS A CORRECT REPRESENTATION OF A SURVEY MADE UNDER MY SUPERVISION ON AUGUST 4, 2010 OF THE SHOWN FEDERAL RGU 432-1-298 AS STAKED ON THE GROUND. FIELD SURVEY DATUM IS NAD 27 COLORADO CENTRAL. VALUES HAVE BEEN CONVERTED TO NAD 83 COLORADO CENTRAL FOR PURPOSES OF THIS PLAT.

NOTES

GPS OPERATOR JOHN RICHARDSON OBSERVED A PDOP OF 2.5.
ALL GPS OBSERVATIONS ARE IN ALL GPS OBSERVATIONS ARE IN COMPLIANCE WITH COGCC RULE NO. 215.
LAND USE: HIGH PLATEAU DESERT
NO IMPROVEMENTS WITHIN 400' RADIUS OF WELL SITE.

FEDERAL RGU 41-1-298 PAD

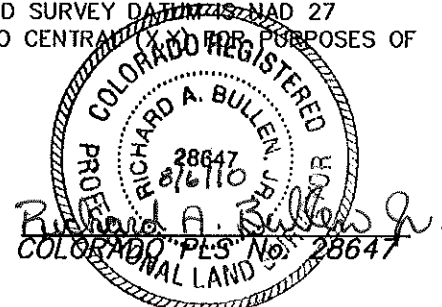

DRG GRIFFIN & ASSOCIATES, INC.
1414 ELK ST., ROCK SPRINGS, WY 82901

(307) 362-5028

DRAWN: 9/14/06

SCALE: 1" = 1000'

REVISED: 8/3/10 - SJC

DRG JOB No. 14650

NEW COORDINATES

EXHIBIT 1

**PLAT OF DRILLING LOCATION
FOR
WILLIAMS PRODUCTION RMT COMPANY**

**803' F/NL & 572' F/EL, NENE, SECTION 1,
T 2 S, R 98 W, 6th P.M.
RIO BLANCO COUNTY, COLORADO**