

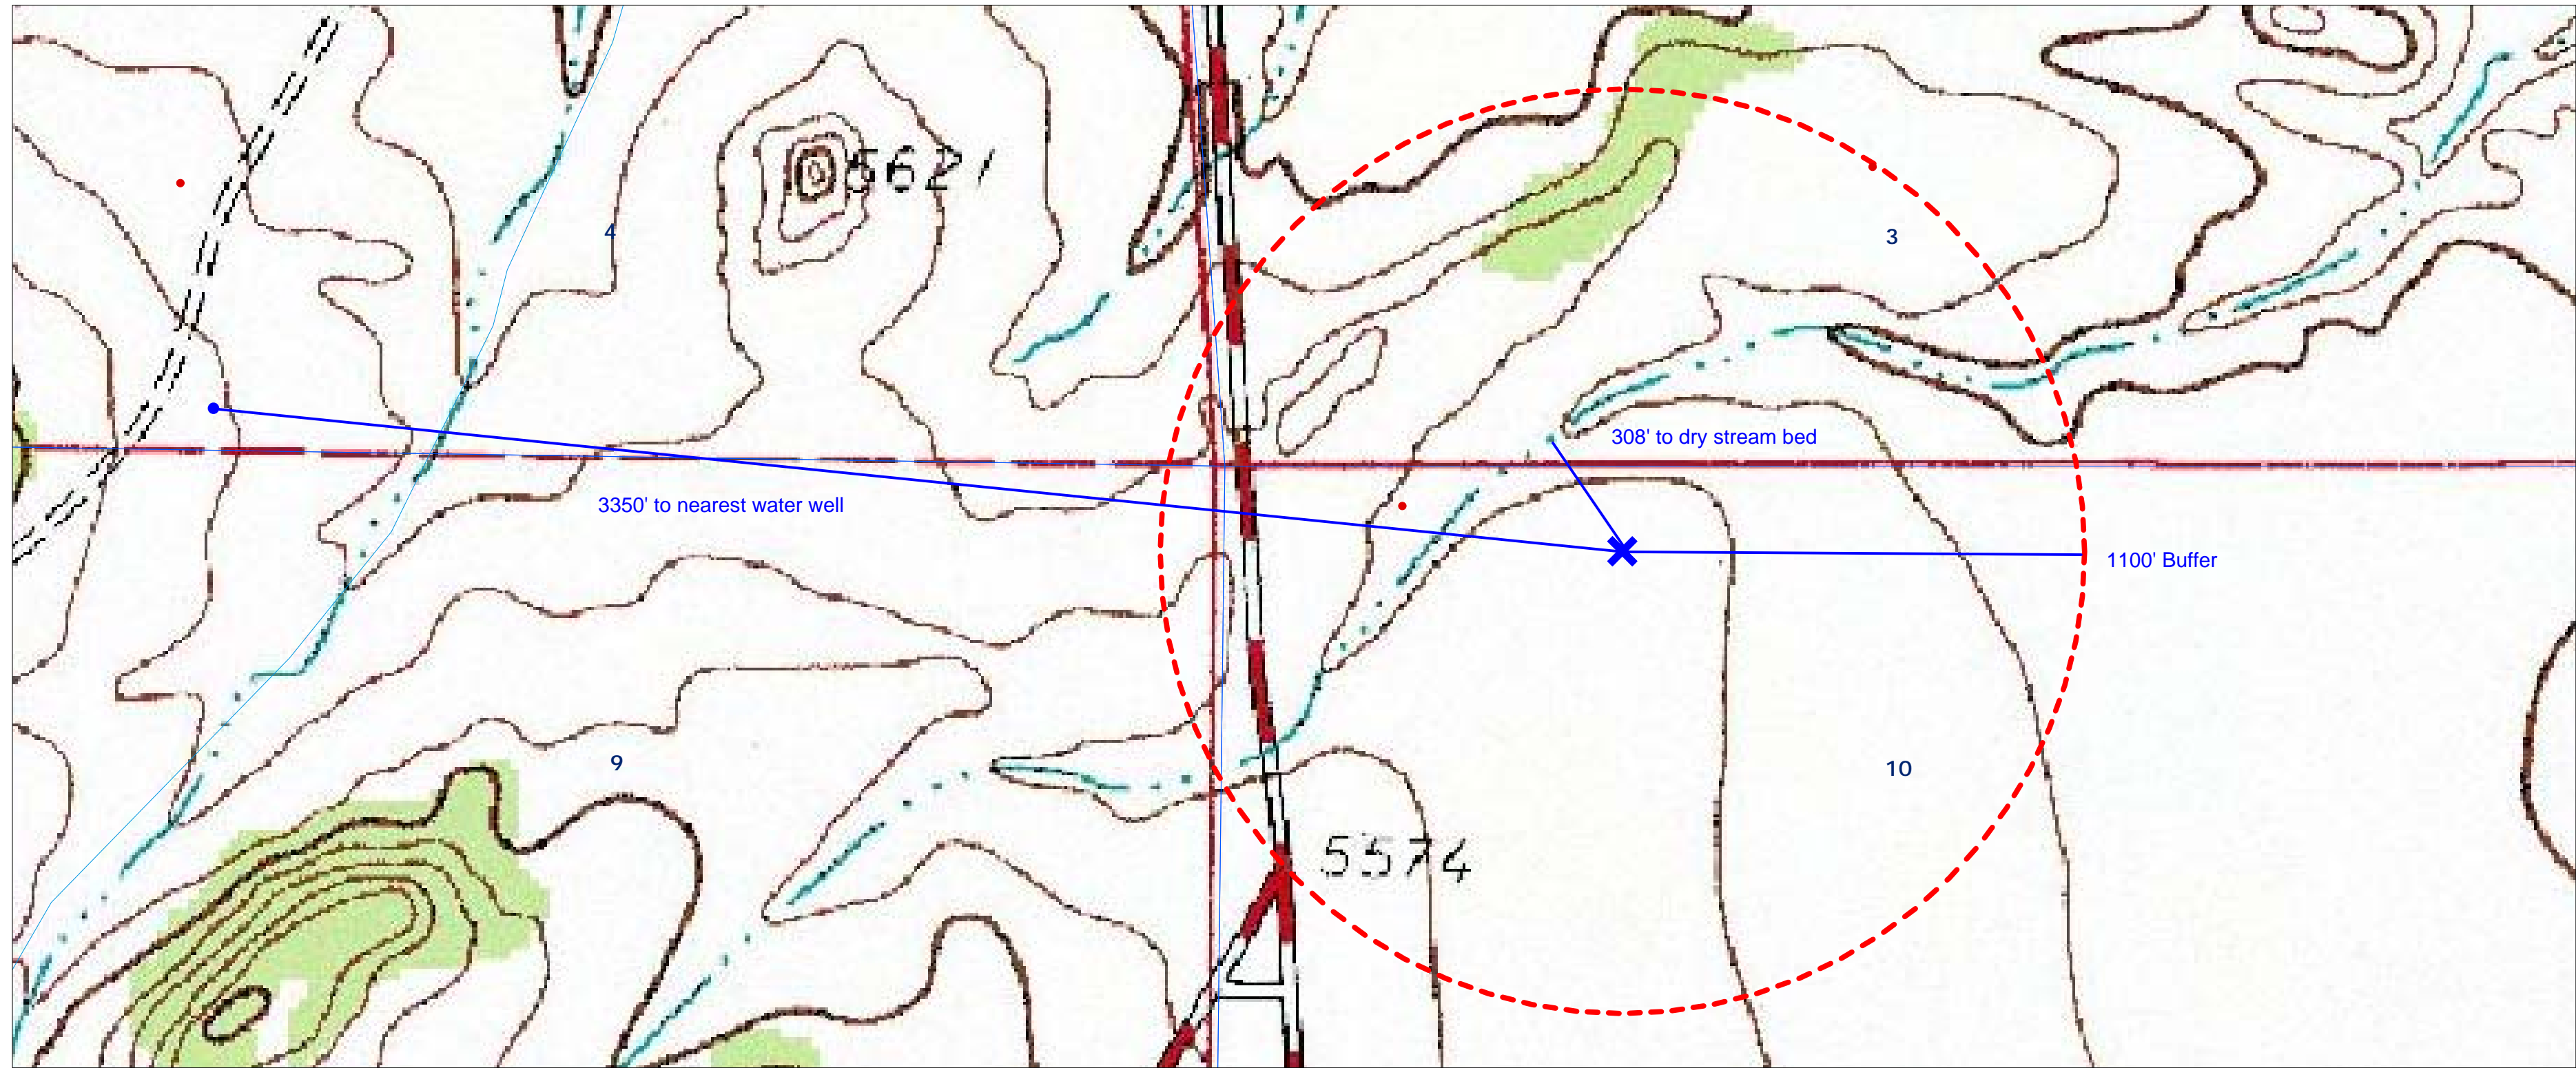


Pine Ridge Oil & Gas, Croaker 11-10, Sec 10, T20S R69W, Hydrology Map

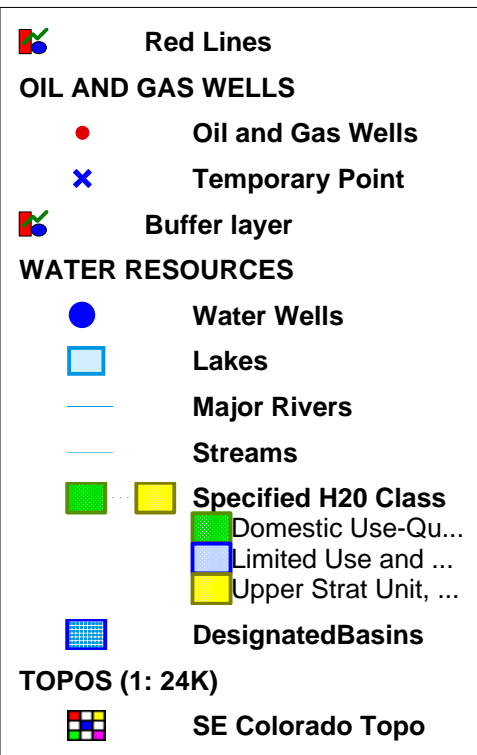

SCALE 1 : 3,778

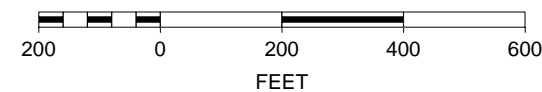

N

