



Pine Ridge Oil & Gas, LLC, Croaker 11-10, Sec 10, T20S R69W, Location Map

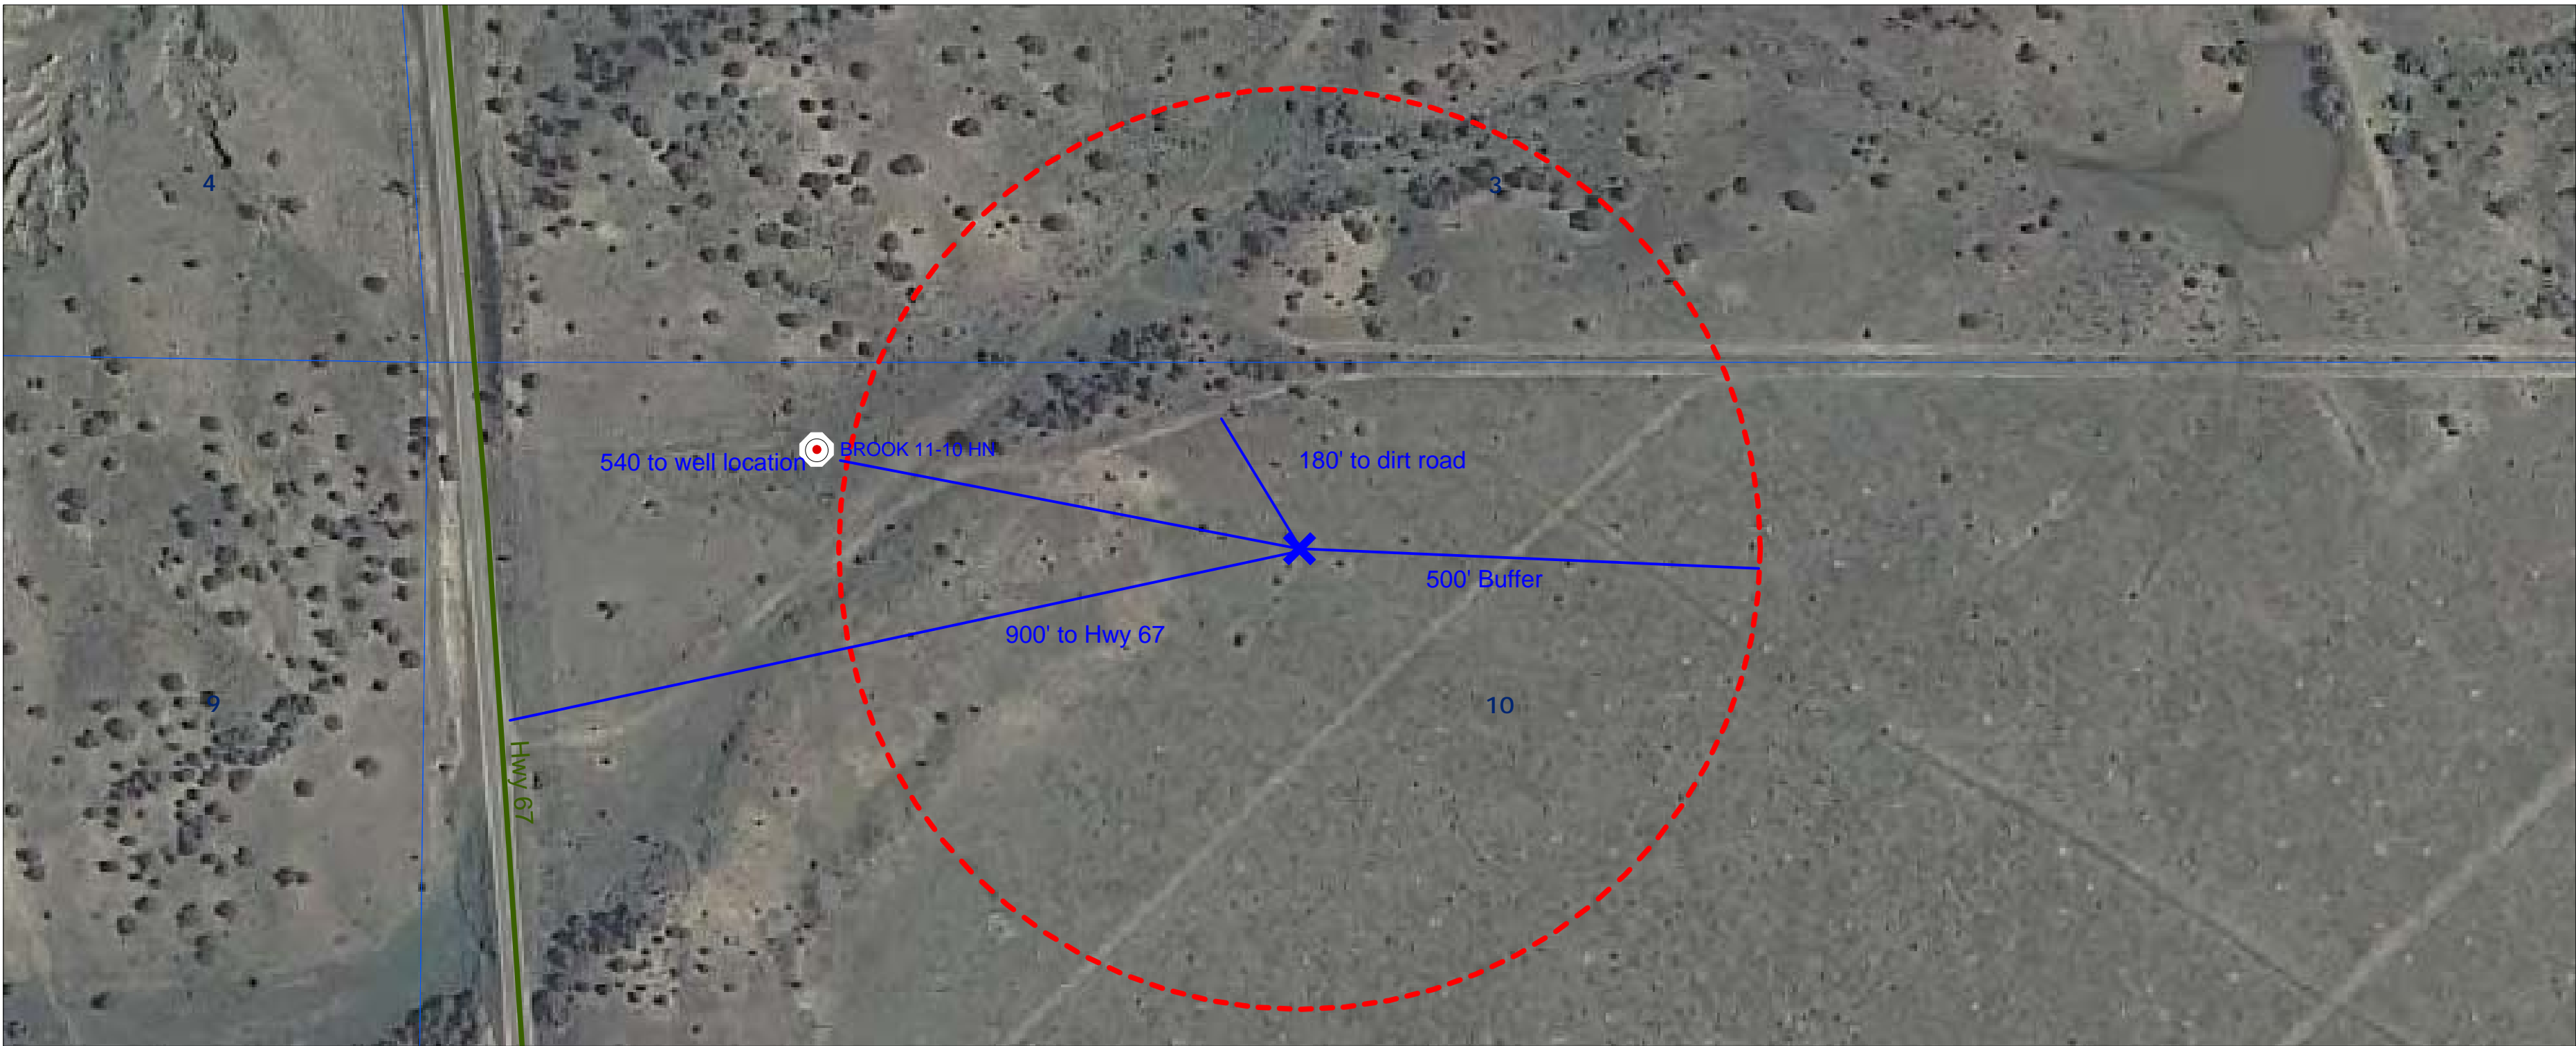

SCALE 1 : 1,730

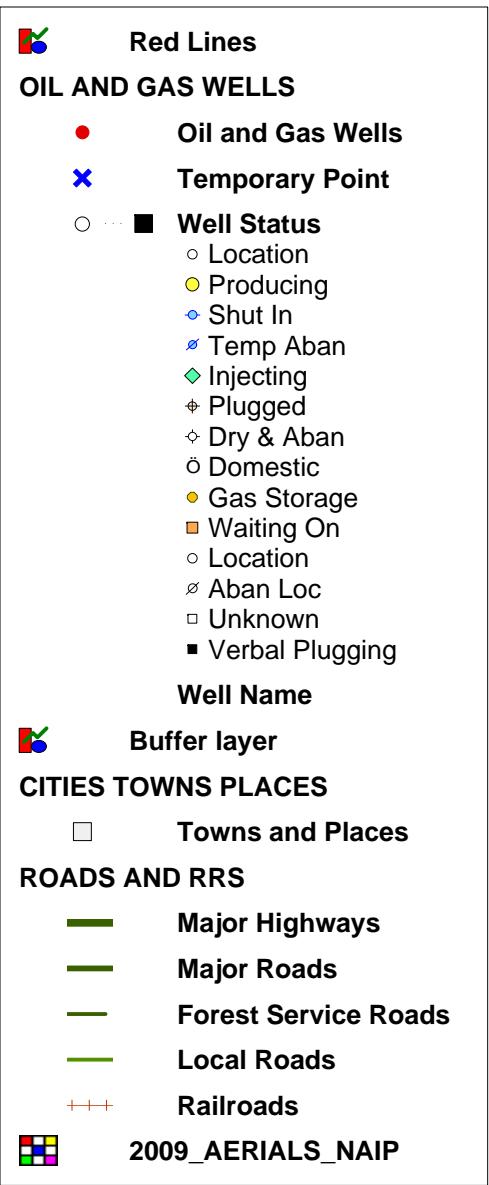