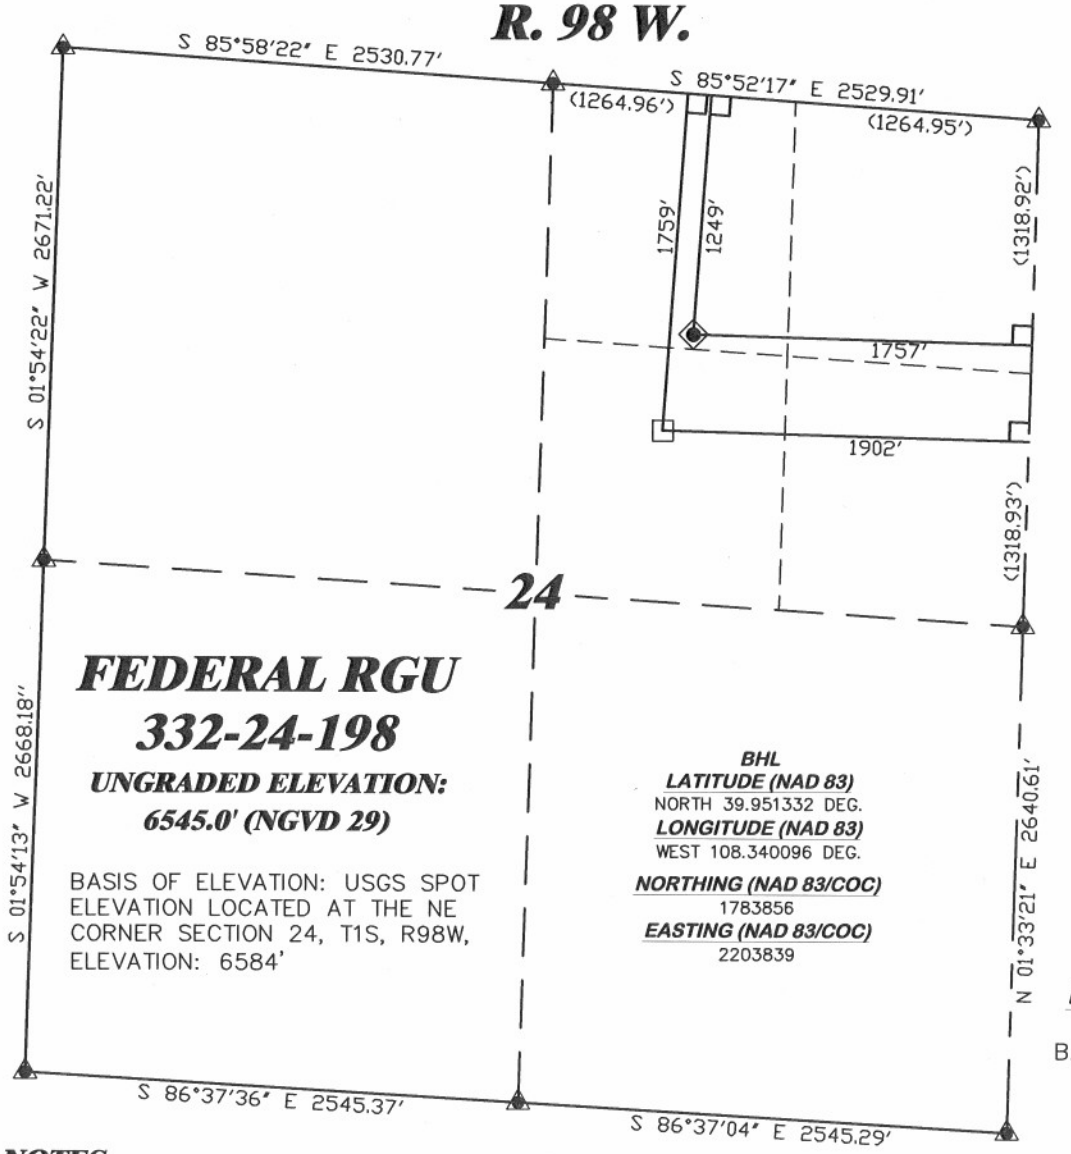

N

SCALE 1" = 1000'

T. 1 S.

LATITUDE (NAD 83)
NORTH 39.952718 DEG.
LONGITUDE (NAD 83)
WEST 108.339585 DEG.

NORTHING (NAD 83/COC)
1784356.00
EASTING (NAD 83/COC)
2203997.44

BASIS OF BEARING/DATUM
SPCS CO NORTH NAD 27
BASED ON NGS TRIANGULATION STATION "BINER"

NOTES

NON CROP, RANGELAND
EXISTING WELL FEATURES WITHIN 400' RADIUS OF WELL SITE.

GPS OPERATOR JOHN RICHARDSON OBSERVED A PDOP OF 1.7.
ALL GPS OBSERVATIONS ARE IN COMPLIANCE WITH COGCC RULE No.215.

1000 500 0 1000 2000
SCALE FEET

SURVEYOR'S STATEMENT

I, CLEMENT R. WILLIAMS, OF ROCK SPRINGS, WYOMING, HEREBY STATE: THIS MAP WAS MADE FROM NOTES TAKEN DURING AN ACTUAL FIELD SURVEY DONE UNDER MY DIRECT SUPERVISION ON JANUARY 26, 2010 AND THAT THIS PLAT CORRECTLY SHOWS THE LOCATION OF FEDERAL RGU 332-24-198 AS STAKED ON THE GROUND. FIELD SURVEY DATUM IS NAD 27 COLORADO NORTH STATE PLANE. VALUES HAVE BEEN CONVERTED TO NAD 83 COLORADO CENTRAL STATE PLANE FOR THE PURPOSES OF THIS PLAT.

COLORADO REGISTERED
CLEMENT RAY WILLIAMS
26977
PROFESSIONAL LAND SURVEYOR

Clement R. Williams
COLORADO PLS No. 26977
3/24/10

LEGEND

- WELL LOCATION
- BOTTOM HOLE LOC. (APPROX)
- FOUND MONUMENT
- PREVIOUSLY FOUND MONUMENT
- DENOTES 90° TIE

FEDERAL RGU 31-24-198 PAD

DRG RIFFIN & ASSOCIATES, INC.
(307) 362-5028
1414 ELK ST., ROCK SPRINGS, WY 82901

PLAT OF DRILLING LOCATION FOR WILLIAMS PRODUCTION RMT COMPANY

DRAWN: 1/12/09 - MMM	SCALE: 1" = 1000'
REVISED: 3/24/10 - MMM	DRG JOB No. 17084
REVISED DATUM	EXHIBIT 1

1249' F/NL & 1757' F/EL, SECTION 24,
T. 1 S., R. 98 W., 6th P.M.
RIO BLANCO COUNTY, COLORADO