


Lat40°, LLC 1635 Foxtrail Drive, Suite 325 Loveland, CO 80538

# PRODUCTION FACILITY LOCATION DRAWING

POWERS X22-02

SECTION: 22  
TOWNSHIP: 2N  
RANGE: 65W

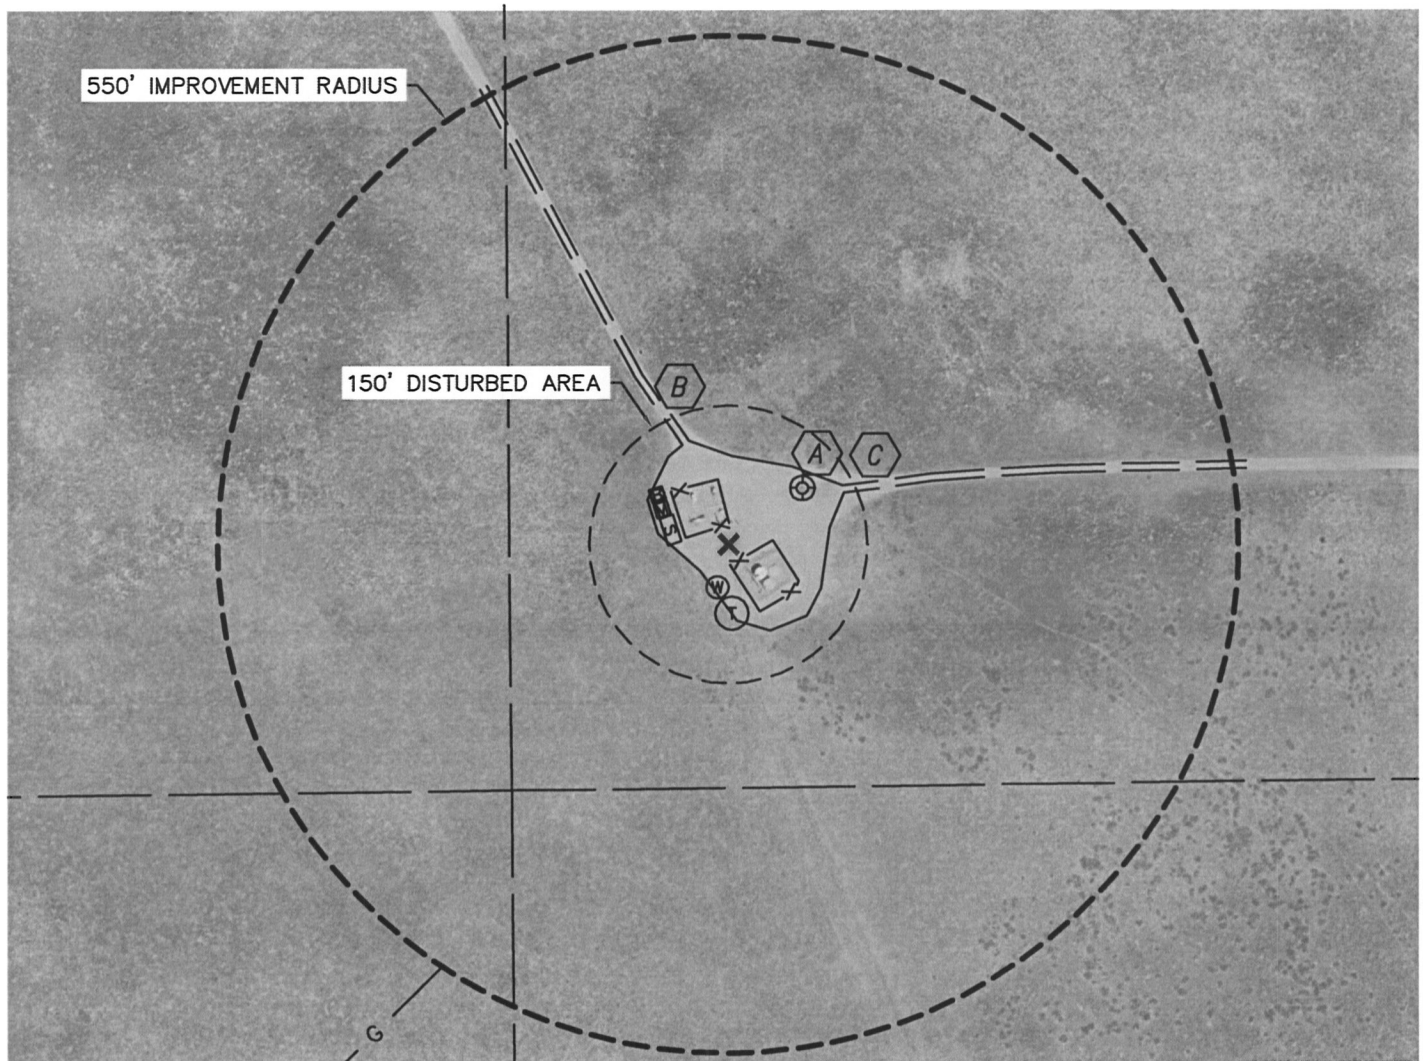

## REFERENCE POINT LOCATION:

LATITUDE: 40.12847°N

LONGITUDE: 104.64453°W

ELEV: 4900

PDOP: 1.8

DATE: 7-26-10

OPERATOR: BRIAN BRINKMAN

1/41/4: NE1/4NE1/4

FNL: 1062'

FEL: 1084'

DISTANCE TO WELL: 704'

ASSOCIATED NEW WELLS:

POWERS X22-02

ASSOCIATED EXISTING WELLS:

ROBERT POWERS X22-7, X22-27

POWERS 21-22, 41-22

## IMPROVEMENTS:



EX. POWERS 41-22 100' NE



FIELD ROAD 120' NW



FIELD ROAD 140' EAST

## LEGEND



REFERENCE POINT



PROPOSED TANK



PROPOSED WATER VAULT



PROPOSED SEPARATOR



PROPOSED BURNER



PROPOSED METER

ALL DISTANCES ARE APPROXIMATE.

NEAREST: BUILDING 3750' N, PUBLIC ROAD 4370' NW,  
ABOVE GROUND UTILITY 1058' E, RAILROAD 5280'+,  
PROPERTY LINE 1062' N

