


SEC. 35, T. 7 S., R. 95 W. OF THE 6TH P.M.

PLAT #1
LOCATION PLAT

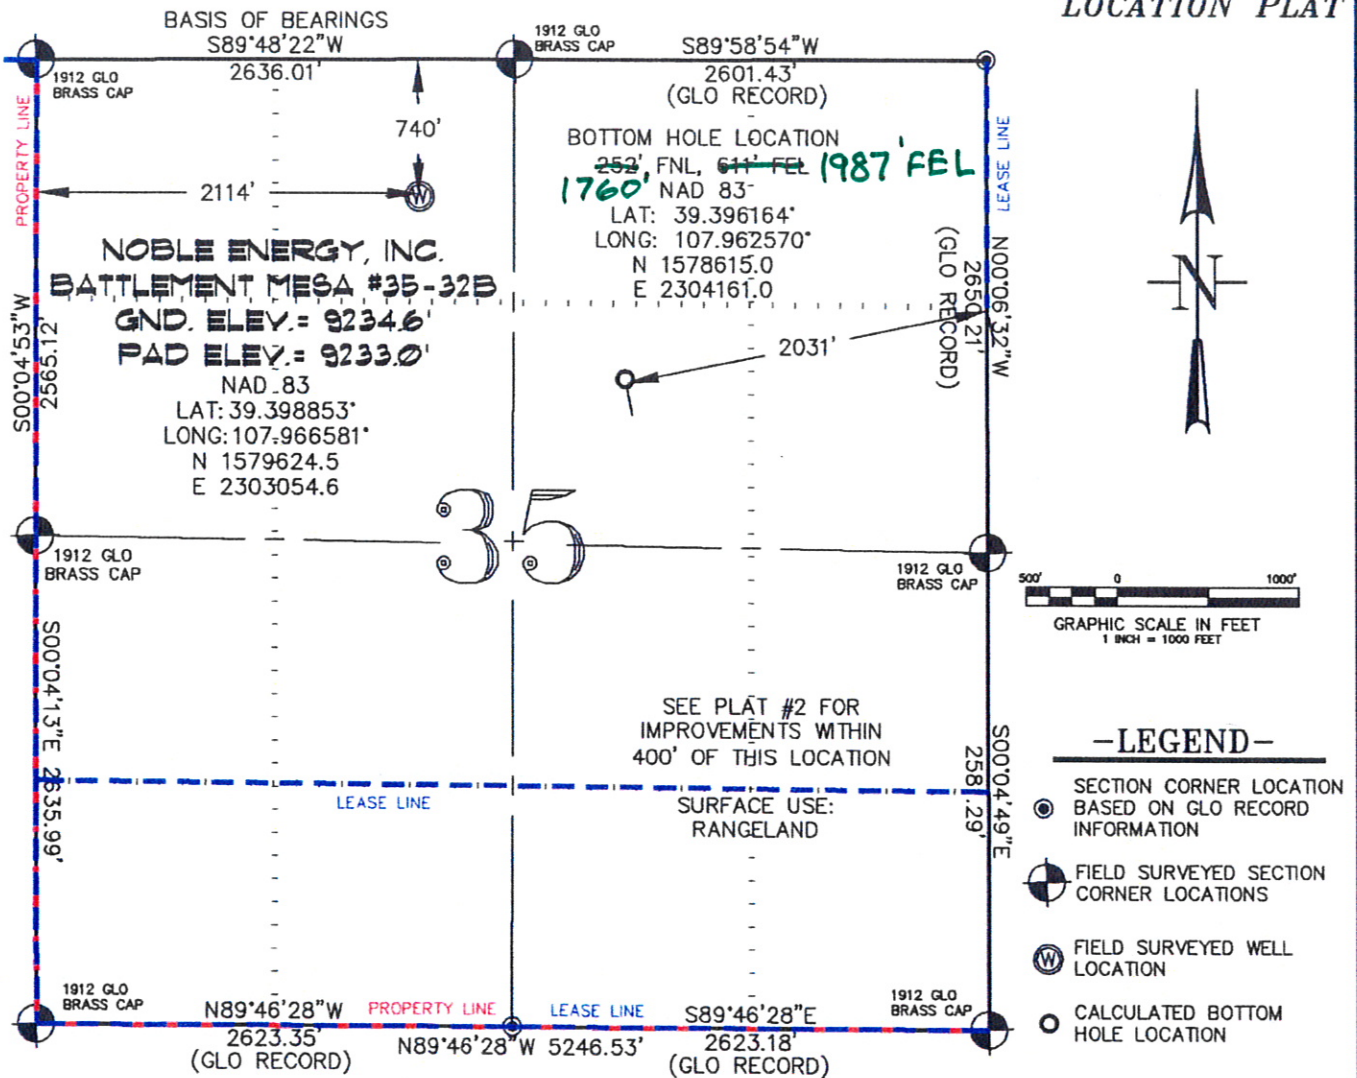


THIS WELL LOCATION PLAT WAS PREPARED FOR NOBLE ENERGY INC. TO LOCATE THE BATTLEMENT MESA #35-32B WELL, 740 FEET FROM THE NORTH LINE AND 2114 FEET FROM THE WEST LINE IN THE NE1/4 NW1/4 OF SECTION 35, T. 7 S., R. 95 W. OF THE 6TH P.M. GARFIELD COUNTY, COLORADO.

REFERENCE NOTES

- 1) T. 7 S., R. 95 W., 6TH P.M. GLO PLAT.
- 2) U.S.G.S. QUAD: PARACHUTE, CO
- 3) ELEVATIONS BASED ON N.A.V.D. 1988
- 4) LATITUDES AND LONGITUDES ARE BASED ON NAD 83, COLORADO CENTRAL ZONE.
- 5) GPS OPERATOR ROBERT WOOD, OBSERVED A PDOP OF 2.0.
- 6) ALL GPS OBSERVATIONS ARE IN COMPLIANCE WITH COGCC RULE NO. 215.
- 7) SURFACE AND BOTTOM HOLE LOCATIONS ARE MEASURED 90° FROM SECTION LINES.

SURVEYOR'S CERTIFICATE

I, George R. Bauer: a Professional Land Surveyor in the State of Colorado do hereby certify that this Survey was made under my direct supervision, and that this Plat represents said Survey.

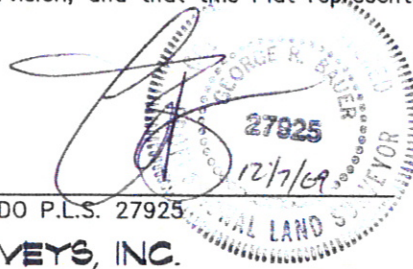

COLORADO P.L.S. 27925



CONSTRUCTION SURVEYS, INC.
0012 SUNRISE BLVD.
SILT, CO 81652
(970)876-5753

VIEW: 1K

SURVEYED: 08/20/09	SCALE: 1" = 1000'
DRAFTED: 12/04/09	DWG: Noble\2006\BM35C
CHECKED: 12/07/09	SHEET: 1 of 10

FORM

2

Rev
12/05

State of Colorado Oil and Gas Conservation Commission

1120 Lincoln Street, Suite 801, Denver, Colorado 80205 Phone: (303) 894-2100 Fax: (303) 894-2109



DE	ET	OE	ES
----	----	----	----

APPLICATION FOR PERMIT TO:

1. ☒ Drill, ☐ Deepen, ☐ Re-enter, ☐ Recomplete and Operate

2. TYPE OF WELL

OIL ☐ GAS ☒ COALBED ☐ OTHER _____
SINGLE ZONE ☐ MULTIPLE ZONE ☒ COMMINGLE ZONE ☐

Refilling ☐
Sidetrack ☐

Document Number:

400031778

Plugging Bond Surety

20030009

3. Name of Operator: NOBLE ENERGY INC 4. COGCC Operator Number: 100322
5. Address: 1625 BROADWAY STE 2200
City: DENVER State: CO Zip: 80202
6. Contact Name: Tania McNutt Phone: (303)228-4392 Fax: (303)228-4286
Email: tmcnutt@nobleenergyinc.com
7. Well Name: BATTLEMENT MESA Well Number: 35-32B (35C)
8. Unit Name (if appl): _____ Unit Number: _____
9. Proposed Total Measured Depth: 11344

WELL LOCATION INFORMATION

10. QtrQtr: NENW Sec: 35 Twp: 7S Rng: 95W Meridian: 6
Latitude: 39.398853 Longitude: -107.966581
Footage at Surface: 740 FNL/FSL 2114 FEL/FWL FWL
11. Field Name: Parachute Field Number: 67350
12. Ground Elevation: 9234.6 13. County: GARFIELD

14. GPS Data:

Date of Measurement: 08/20/2009 PDOP Reading: 2.0 Instrument Operator's Name: Robert Wood

15. If well is
- ☒
- Directional
- ☐
- Horizontal (highly deviated)
- submit deviated drilling plan.**

Footage at Top of Prod Zone: FNL/FSL 1987 FEL/FWL 1987 Bottom Hole: FNL/FSL 1987 FEL/FWL 1987
1760 252 FNL 611 FEL 1760 252 FNL 611 FEL
Sec: 35 Twp: 7S Rng: 95W Sec: 35 Twp: 7S Rng: 95W

16. Is location in a high density area? (Rule 603b)? ☐ Yes ☒ No
17. Distance to the nearest building, public road, above ground utility or railroad: 5485 ft
18. Distance to nearest property line: 2114 ft 19. Distance to nearest well permitted/completed in the same formation: 272 ft

20.

LEASE, SPACING AND POOLING INFORMATION

Objective Formation(s)	Formation Code	Spacing Order Number(s)	Unit Acreage Assigned to Well	Unit Configuration (N/2, SE/4, etc.)
Williams Fork	WMFK	139-53	640	