


VISIBLE IMPROVEMENTS

SECTION: 4
TOWNSHIP: 6N
RANGE: 63W

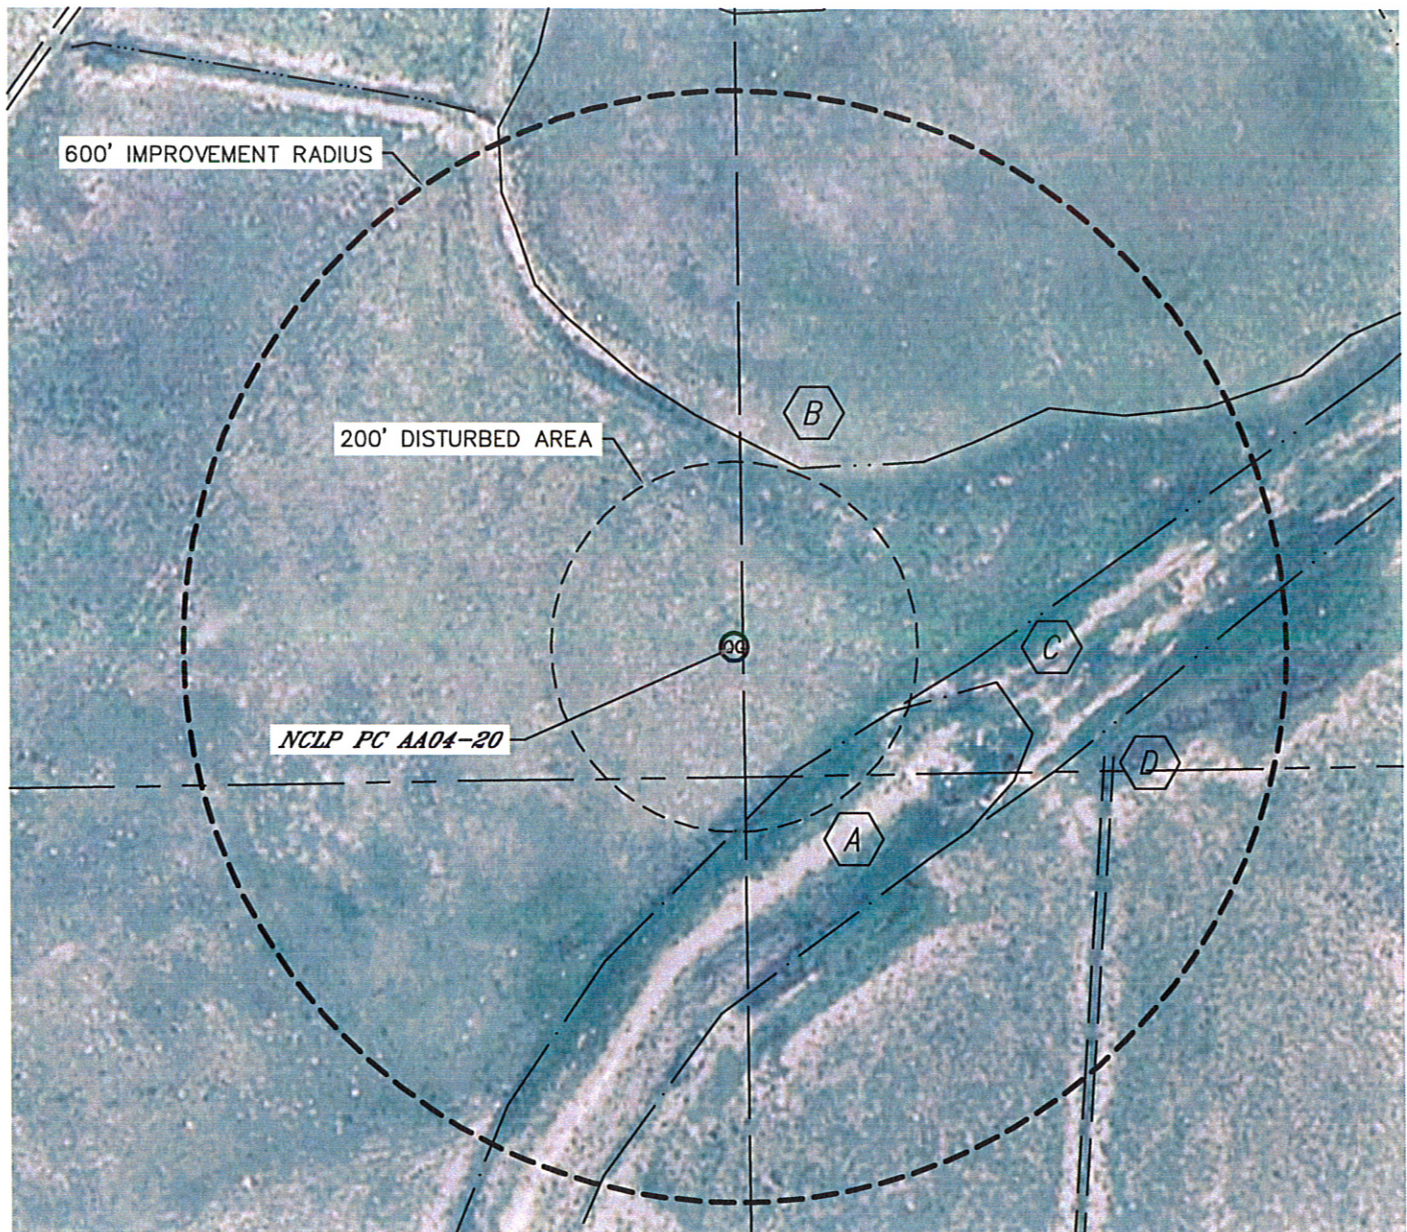

IMPROVEMENTS:

-  BERM 150' SE
-  DRY POND 210' N
-  WET AREA 325' E
-  FIELD ROAD 420' SE

