


There are no visible improvements within 400 feet of the location.

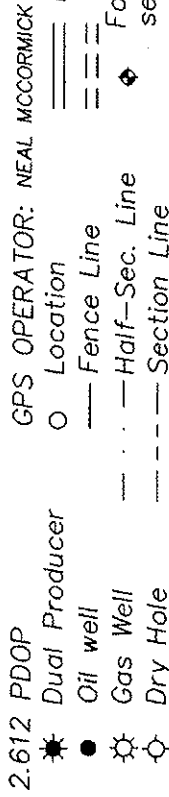

DATE OF FIELD WORK:
02 SEPTEMBER 2010
HICKERT 32-34

SW 1/4 NE 1/4 SEC. 34, T2S, R49W

EDWARD MIKE DAVIS, LLC

WASHINGTON COUNTY, COLORADO

20575 Co. Rd. 21 Phone 970-774-3602
Haxtun, CO 80731 Fax 970-774-3601

W342S49GPS

2435-287