


# ACCESS ROAD MAP


LOYD PC GD33-13

SECTION 33  
TOWNSHIP 12 NORTH  
RANGE 61 WEST

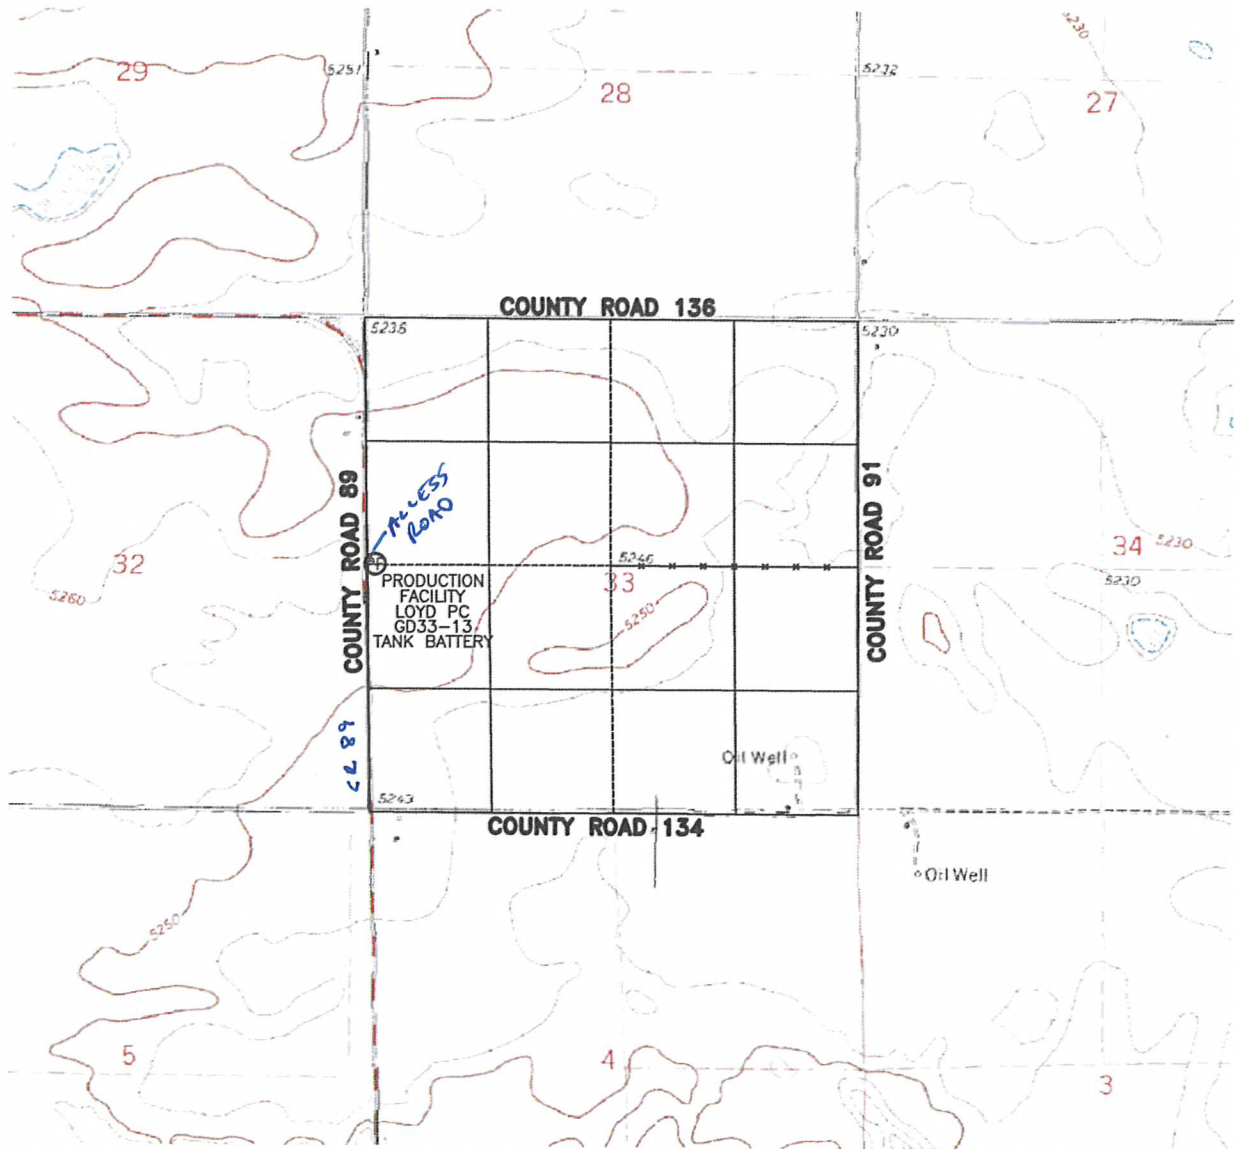

SCALE: 1"=2000'

0 1000 2000

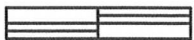

SCALE IN FEET