


# WELL LOCATION CERTIFICATE


THIS MAP DOES NOT REPRESENT A BOUNDARY SURVEY

SECTION 33  
TOWNSHIP 12 NORTH  
RANGE 61 WEST

R 61 W

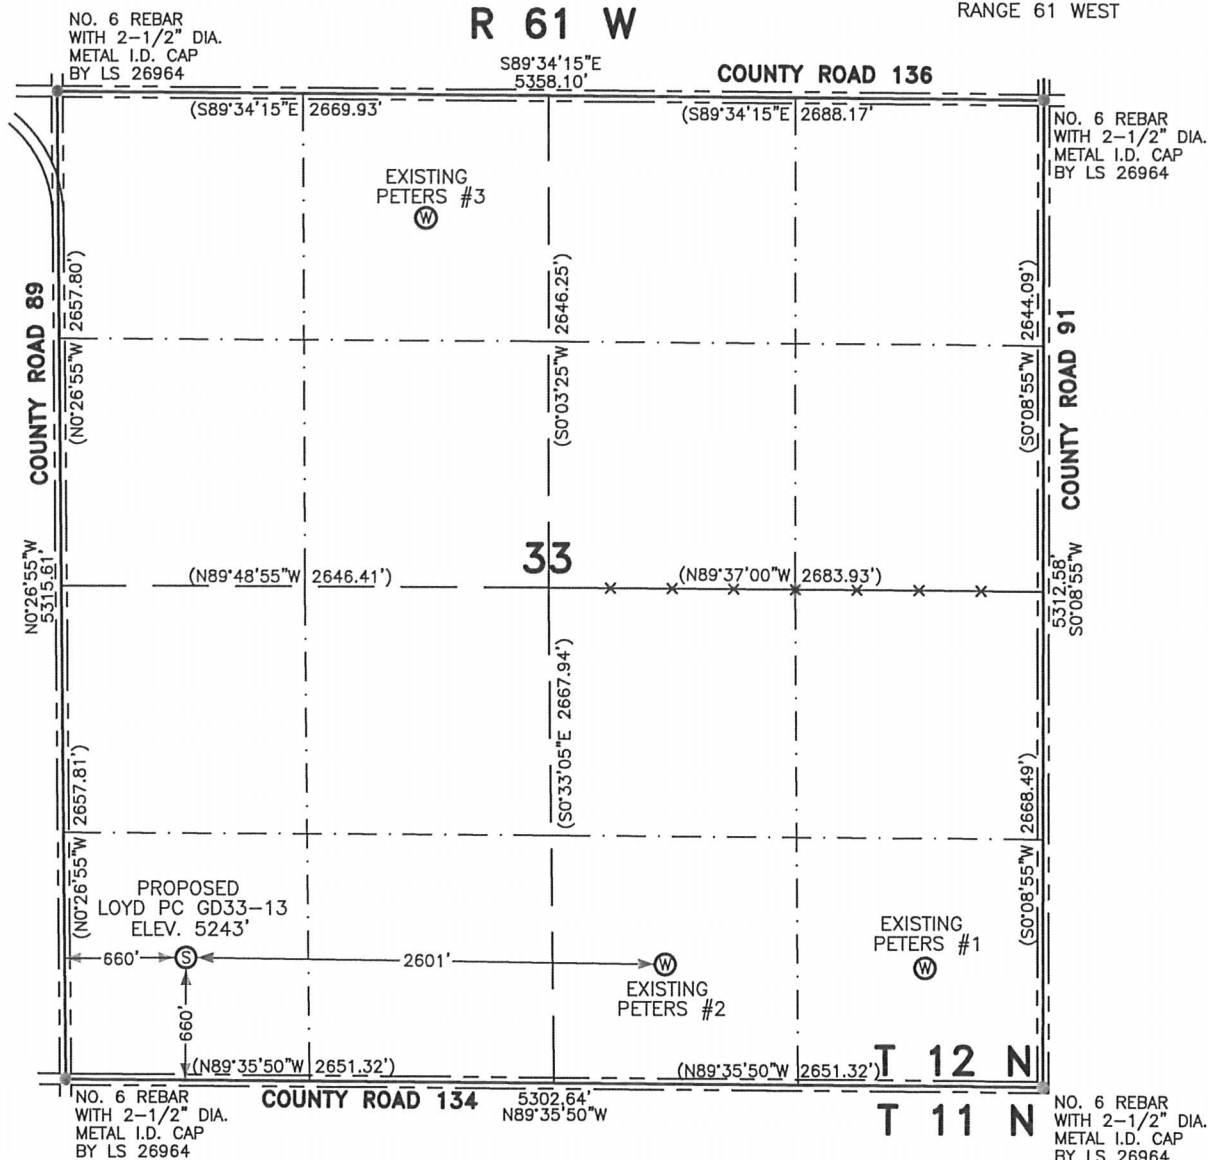


SECTION 33  
TOWNSHIP 12 NORTH  
RANGE 61 WEST

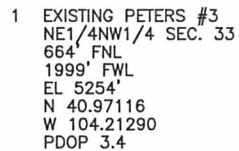


- 2 EXISTING PETERS #1  
SE1/4SE1/4 SEC. 33  
635' FSL  
638' FEL  
EL 5230'  
N 40.96008  
W 104.20312  
PDOP 2.2

- 3 EXISTING PETERS #2  
SW1/4SE1/4 SEC. 33  
644' FSL  
2049' FEL  
EL 5236'  
N 40.96014  
W 104.20823  
PDOP 2.2

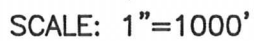

0      500    1000

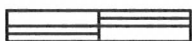

NOTES:

- NOTES:
- 1) THIS SKETCH DOES NOT REPRESENT A BOUNDARY SURVEY.
  - 2) THE DATUM FOR THE LATITUDES AND LONGITUDES ON THIS SKETCH IS NAD83.
  - 3) ELEVATIONS ARE BASED UPON NGS OPUS SOLUTION NAVD 88 DATUM.

⑤ PROPOSED SURFACE LOCATION

☒ EXISTING WELL

== == == == ROAD

— x — x — FENCE

CALCULATED DIMENSIONS  
ARE IN PARENTHESES