

# BASHOR PC AA17-21 TANK

Steil Surveying Services, LLC

1102 West 19th Street P.O. BOX 2073

Cheyenne, Wyoming 82009

## PRODUCTION FACILITY LOCATION DRAWING


FOR THE PROPOSED BASHOR PC AA17-21, 22, 23, 24, 15 & 16 *Peppler PCAA*

SECTION 17  
TOWNSHIP 6 NORTH  
RANGE 63 WEST

DATE: 06/23/2010

THIS MAP DOES NOT REPRESENT A BOUNDARY SURVEY

*17-20*

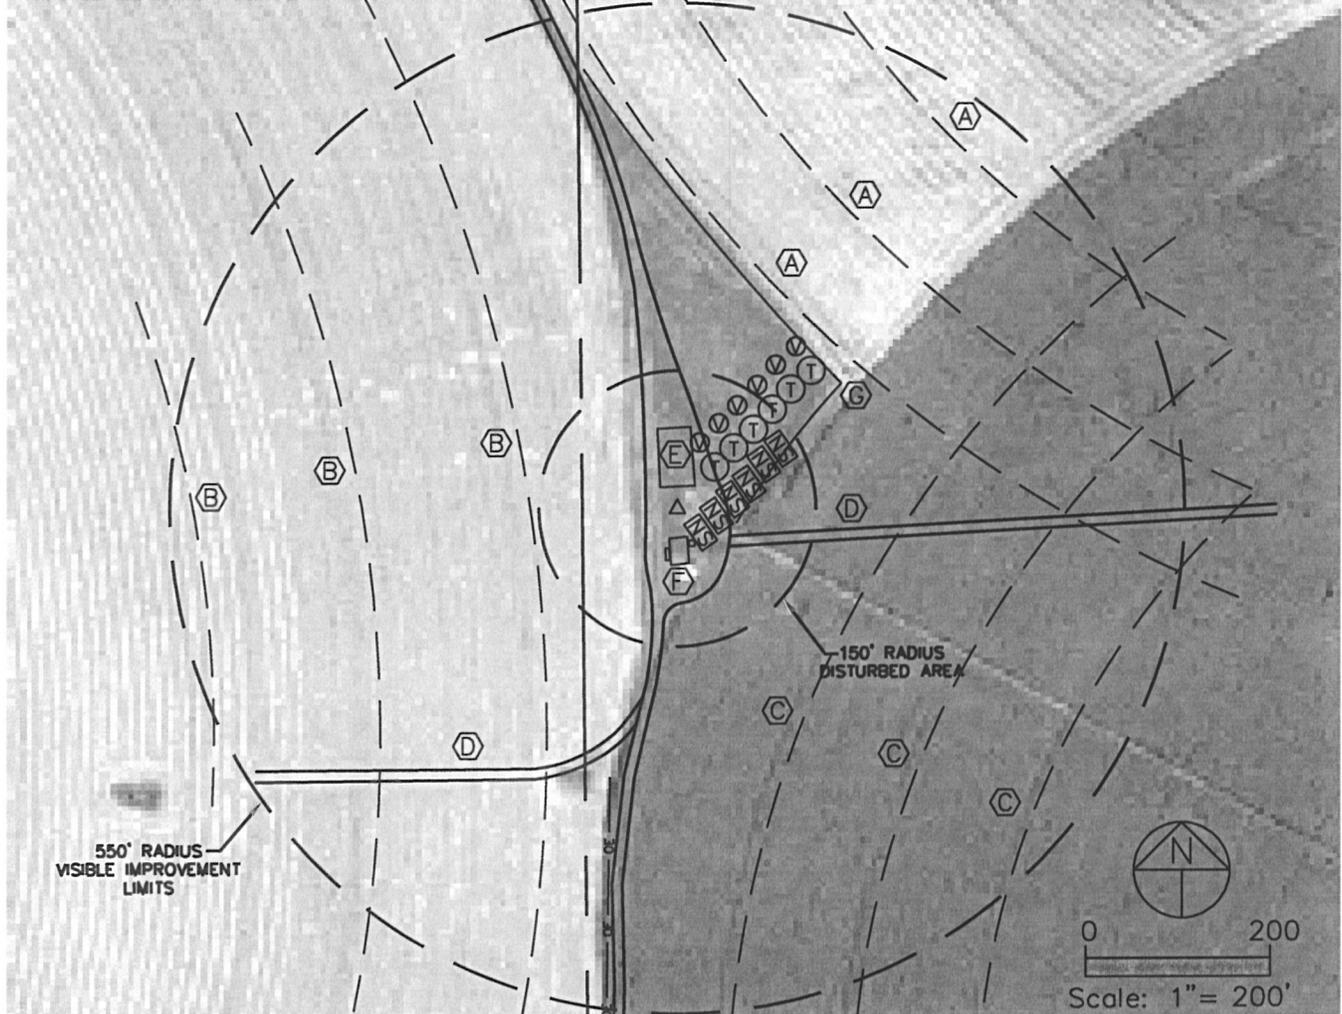

**REFERENCE POINT LOCATION:**

LAT: N 40.48486  
LONG: W 104.46054  
PDOP: 3.1, ELEV. 4673'  
NW $\frac{1}{4}$ SE $\frac{1}{4}$  SEC. 17  
2009' FSL, 2517' FEL

**ASSOCIATED NEW WELLS:**  
BASHOR PC AA17-21, 22,  
23, 24, 15, 16

*Peppler PCAA 17-20*

**ASSOCIATED EXISTING WELLS:**  
BASHOR 17-13  
BASHOR 17-42

**NEAREST PROPERTY LINE:**  
103' WEST

**NEAREST OVERHEAD POWER LINE:**  
301' SOUTHWEST

**NOTE:** Distances shown are to the proposed production facility reference point and were scaled from Weld County aerial photography. Improvements not shown on aerial photography were field verified.

**IMPROVEMENTS:**

- (A) IRRIGATION WHEEL TRACKS - 248', 362' & 498' NORTHEAST
- (B) IRRIGATION WHEEL TRACKS - 158', 338' & 519' WEST
- (C) IRRIGATION WHEEL TRACKS - 221', 355' & 490' SOUTHEAST
- (D) DIRT ROADS - 64' SOUTHEAST & 208' SOUTH
- (E) EXISTING NOBLE ENERGY TANKS - 24' NORTH
- (F) EXISTING NOBLE ENERGY SEPARATOR - 31' SOUTH
- (G) CROP LINE - 100'+/- EAST AND 250'+/- NORTHEAST

**LEGEND:**

- $\Delta$  REFERENCE POINT
- $\nabla$  PROPOSED WATER VAULT
- $\odot$  PROPOSED TANK
- $\square$  PROPOSED SEPARATOR