

State of Colorado
Oil and Gas Conservation Commission

11201 Lincoln Street, Suite 801, Denver, Colorado 80203 Phone: (303)984-2100 Fax: (303)984-2109

SUNDRY NOTICE

Submit original plus one copy. This form is to be used for general, technical and environmental sundry information. For proposed or completed operations, describe in full on Technical Information Page (Page 2 of this form.) Identify well or other facility by API Number or by OGCC Facility ID. Operator shall send an informational copy of all sundry notices for wells located in High Density Areas to the Local Government Designee (Rule 603b.)



022054503



RECEIVED

OCT 01 2010

OGCC/Rifle Office

1. OGCC Operator Number: 10071		4. Contact Name	
2. Name of Operator: Bill Barrett Corporation		Elaine Winick	
3. Address: 1099 18th Street, Suite 2300		Phone: (303) 312-8168	
City: Denver State: CO Zip: 80202		Fax: (303) 291-0420	
5. API Number 05-045-18907		OGCC Facility ID Number	
6. Well/Facility Name: GGU Fed		7. Well/Facility Number 44B-29-691	
8. Location (Qtr/Qt, Sec, Twp, Rng, Meridian): NWNW, Sec. 33 T6S, R91W, 6th PM		Survey Plot	
9. County: Garfield		Directional Survey	
10. Field Name: Marmion Creek		Surface Ecpm Diagram	
11. Federal, Indian or State Lease Number: COC-46972		Technical Info Page	
		Other	

Complete the Attachment
Checklist

OP OGCC

General Notice

<input type="checkbox"/> CHANGE OF LOCATION: Attach New Survey Plat		(a change of surface qtr/qr is substantive and requires a new permit)	
Change of Surface Footage from Exterior Section Lines:		FNU/FSL FEL/FWL	
Change of Surface Footage to Exterior Section Lines:			
Change of Bottomhole Footage from Exterior Section Lines:			
Change of Bottomhole Footage to Exterior Section Lines:		attach directional survey	
Bottomhole location Qtr/Qt, Sec, Twp, Rng, Mer		Distance to nearest bldg, public rd, utility or RR	
Latitude		Distance to nearest property line	
Longitude		Distance to nearest lease line	
Ground Elevation		Distance to nearest well same formation	
GPS DATA:		Surface owner consultation data:	
Date of Measurement		POOP Reading	
Instrument Operator's Name			
<input type="checkbox"/> CHANGE SPACING UNIT		<input type="checkbox"/> Remove from surface bond	
Formation		Signed surface use agreement attached	
Formation Code		Unit configuration	
Spacing order number		Unit acreage	
Unit configuration		Unit configuration	
<input type="checkbox"/> CHANGE OF OPERATOR (prior to drilling):		<input type="checkbox"/> CHANGE WELL NAME	
Effective Date:		From:	
Plugging Bond: <input type="checkbox"/> Blanket <input type="checkbox"/> Individual		To:	
Effective Date:		Effective Date:	
<input type="checkbox"/> ABANDONED LOCATION:		<input type="checkbox"/> NOTICE OF CONTINUED SHUT IN STATUS	
Was location ever built? <input type="checkbox"/> Yes <input type="checkbox"/> No		Date well shut in or temporarily abandoned:	
Is site ready for inspection? <input type="checkbox"/> Yes <input type="checkbox"/> No		Has Production Equipment been removed from site? <input type="checkbox"/> Yes <input type="checkbox"/> No	
Data Ready for inspection:		MIT required if shut in longer than two years. Date of last MIT	
<input type="checkbox"/> SPUD DATE:		<input type="checkbox"/> REQUEST FOR CONFIDENTIAL STATUS (6 mos from date casing set)	
<input type="checkbox"/> SUBSEQUENT REPORT OF STAGE, SQUEEZE OR REMEDIAL CEMENT WORK		*submit cbl and cement job summaries	
Method used		Cement top	
Cementing tool setting/perf depth		Cement bottom	
Cement volume		Date	
<input type="checkbox"/> RECLAMATION: Attach technical page describing final reclamation procedures per Rule 1004.		<input type="checkbox"/> Final reclamation is completed and site is ready for inspection.	
Final reclamation will commence on approximately			

Technical Engineering/Environmental Notice

<input type="checkbox"/> Notice of Intent	<input type="checkbox"/> Report of Work Done
Approximate Start Date:	Date Work Completed:
Details of work must be described in full on Technical Information Page (Page 2 must be submitted.)	
<input type="checkbox"/> Intent to Recomplete (submit form 2)	<input type="checkbox"/> Request to Vent or Flare
<input type="checkbox"/> Change Drilling Plans	<input type="checkbox"/> Repair Well
<input type="checkbox"/> Gross Interval Changed?	<input type="checkbox"/> Rule 502 variances requested
<input type="checkbox"/> Casing/Cementing Program Change	<input checked="" type="checkbox"/> Other: Request to Complete
for Spills and Releases	
<input type="checkbox"/> E&P Waste Disposal	
<input type="checkbox"/> Beneficial Reuse of E&P Waste	
<input type="checkbox"/> Status Update/Change of Remediation Plans	

I hereby certify that the statements made in this form are, to the best of my knowledge, true, correct and complete.

Signed:

Elaine Winick

Date: 10-1-10

Email: ewinick@billbarrettcorp.com

Print Name: Elaine Winick

Title: Permit Analyst

OGCC Approved:

Elaine Winick

Title:


ETII

Date: 10/4/10

CONDITIONS OF APPROVAL, IF ANY:



TECHNICAL INFORMATION PAGE

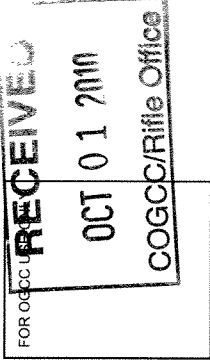

1. OGCC Operator Number:	10071	API Number:	05-045-18907
2. Name of Operator:	Bill Barrett Corporation		
		OGCC Facility ID #	
3. Well/Facility Name:	GGU Fed	Well/Facility Number:	44B-32-691
4. Location (QtrQtr, Sec, Twp, Rng, Meridian):	NWNW, Sec. 33 T6S, R91W, 6th PM		

This form is to be completed whenever a Sundry Notice is submitted requiring detailed report of work to be performed or completed. This form shall be transmitted within 30 days of work completed as a "subsequent" report and must accompany Form 4, page 1.

5. DESCRIBE PROPOSED OR COMPLETED OPERATIONS

The referenced well has been successfully cemented according to the approved plan and a summary of the Bradenhead monitoring. Bill Barrett Corporation requests approval to commence completion operations.

Attachments:

CBL
AS-BUILT WELLBORE SCHEMATIC
TEMPERATURE SURVEY
BRADENHEAD PRESSURE SUMMARY


9" → 9" 10"

BUPA@

CBL TOC ~2304'

JEK

10/4/10

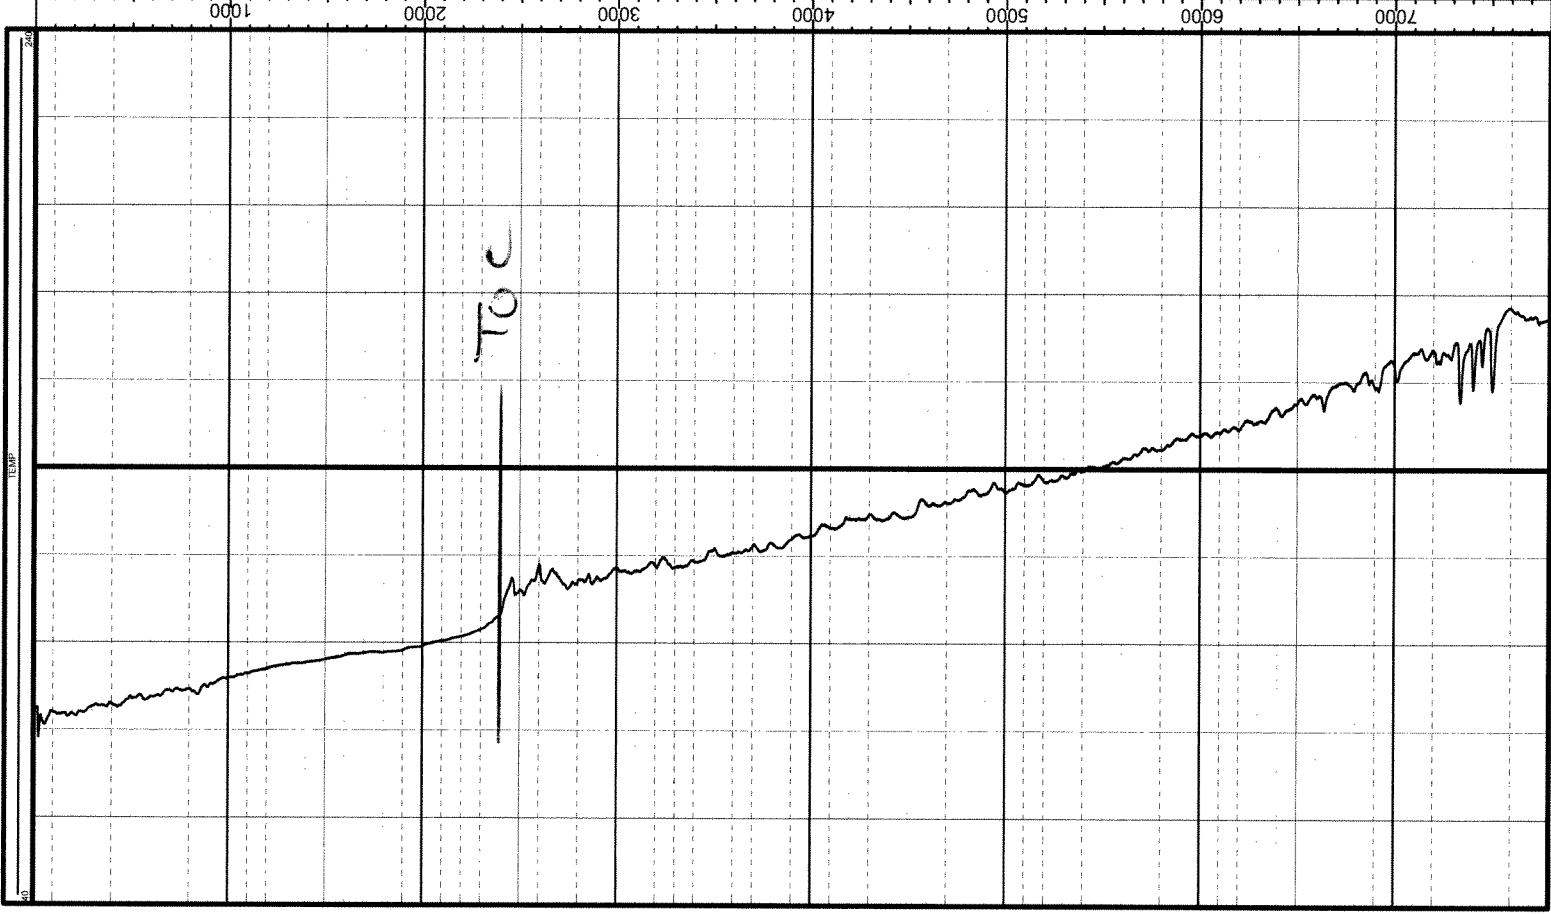

~2400'
JEL
10/4/10

RECEIVED

OCT 01 2010

COGCC/Rifle Office

Well Name: GGU Fed 448-29-491

SHL: 353 FNL 260 FWL Section 33, T6S-R91W

BHL: 490 FSL 664 FEL Section 29, T6S-R91W

Bill Barrett Corporation

API #: 05-045-18907

Date Created: 9/15/2010

County: Garfield

PROPOSED WELLBORE DIAGRAM

PROPOSED vs ACTUAL WELLBORE DIAGRAM

