



Physical Address: 401 Arapahoe St.
 Mail to: Box 384 Kiowa, CO 80117
 Ph. 303-621-8672 - Fax 303-621-2717
 www.highprairiesurvey.com

Job # 10174 Dunlap #1

Inv # 1305

High Prairie Surveying of Kiowa, Colorado has in accordance with a request from **Val Energy, Inc.** has determined the location of **Dunlap #1** to be **1980 feet FNL**, and **660 feet FEL**, (90° off Section lines) of **SECTION 9**, Township **17s**, Range **48w** of the 6th Principal Meridian, **Kiowa County**, Colorado.

Date: Staked on 9-28-10 drawn on 9-29-10.



Re: Staked by Keith Westfall

Drawn: Drawn by Elijah Frane

Basis of Elevation Spot: USGS BM = F-37, PID = JJ0291, H-Order = First, V-Order = First, Stability = C, P-DOP = 2.20, Sats = 8 US NAD 83-Zone CO C0502, Lat. = 38.63331, Long. = 102.78615, Elevation = 4220.45 gr. (us FT).

Notes: There are no apparent improvements within 400 ft.
 The ground elevation at staked location = 4246.61' gr.
 This drawing does not represent a monumented survey or Land Survey Plat.

Basis of Bearing: Bearings were determined based on the East line of Section 19 to bear N01°16'55"W with all other bearings contained herein relative thereto.

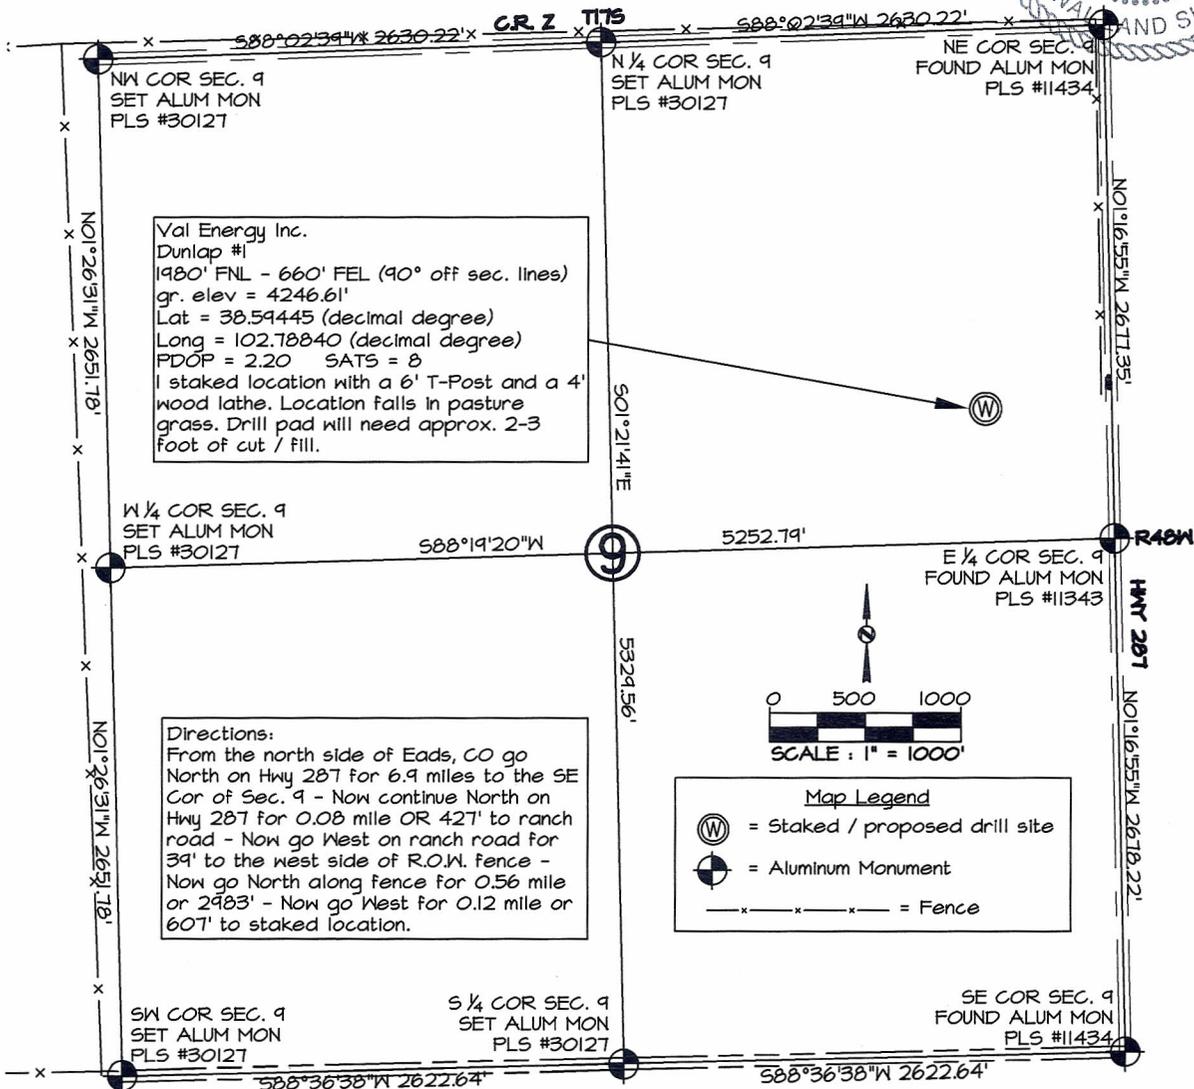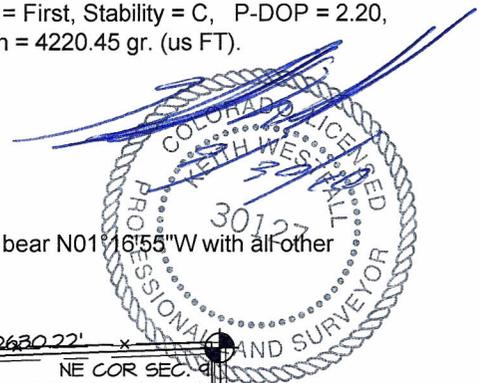



Physical Address: 401 Arapahoe St.
 Mail to: Box 384 Kiowa, CO 80117
 Ph. 303-621-8672 - Fax 303-621-2717
 www.highprairiesurvey.com

Job # 10174 Dunlap #1

Inv # 1305

High Prairie Surveying of Kiowa, Colorado has in accordance with a request from **Val Energy, Inc.** has determined the location of **Dunlap #1** to be 1980 feet FNL, and 660 feet FEL, (90° off Section lines) of SECTION 9, Township 17s, Range 48w of the 6th Principal Meridian, **Kiowa County**, Colorado.

Date: Staked on 9-28-10 drawn on 9-29-10.

Re: Staked by Keith Westfall

Drawn: Drawn by Elijah Frane

Basis of Elevation Spot: USGS BM = F-37, PID = JJ0291, H-Order = First, V-Order = First, Stability = C, P-DOP = 2.20, Sats = 8 US NAD 83-Zone CO C0502, Lat. = 38.63331, Long. = 102.78615, Elevation = 4220.45 gr. (US F.T.)

Notes: There are no apparent improvements within 400 ft.
 The ground elevation at staked location = 4246.61' gr.
 This drawing does not represent a monumented survey or Land Survey Plat.

Basis of Bearing: Bearings were determined based on the East line of Section 19 to bear N01°16'55"W with all other bearings contained herein relative thereto.

