


WELL LOCATION CERTIFICATE

THIS MAP DOES NOT REPRESENT A BOUNDARY SURVEY

SECTION: 16
TOWNSHIP: 4N
RANGE: 66W

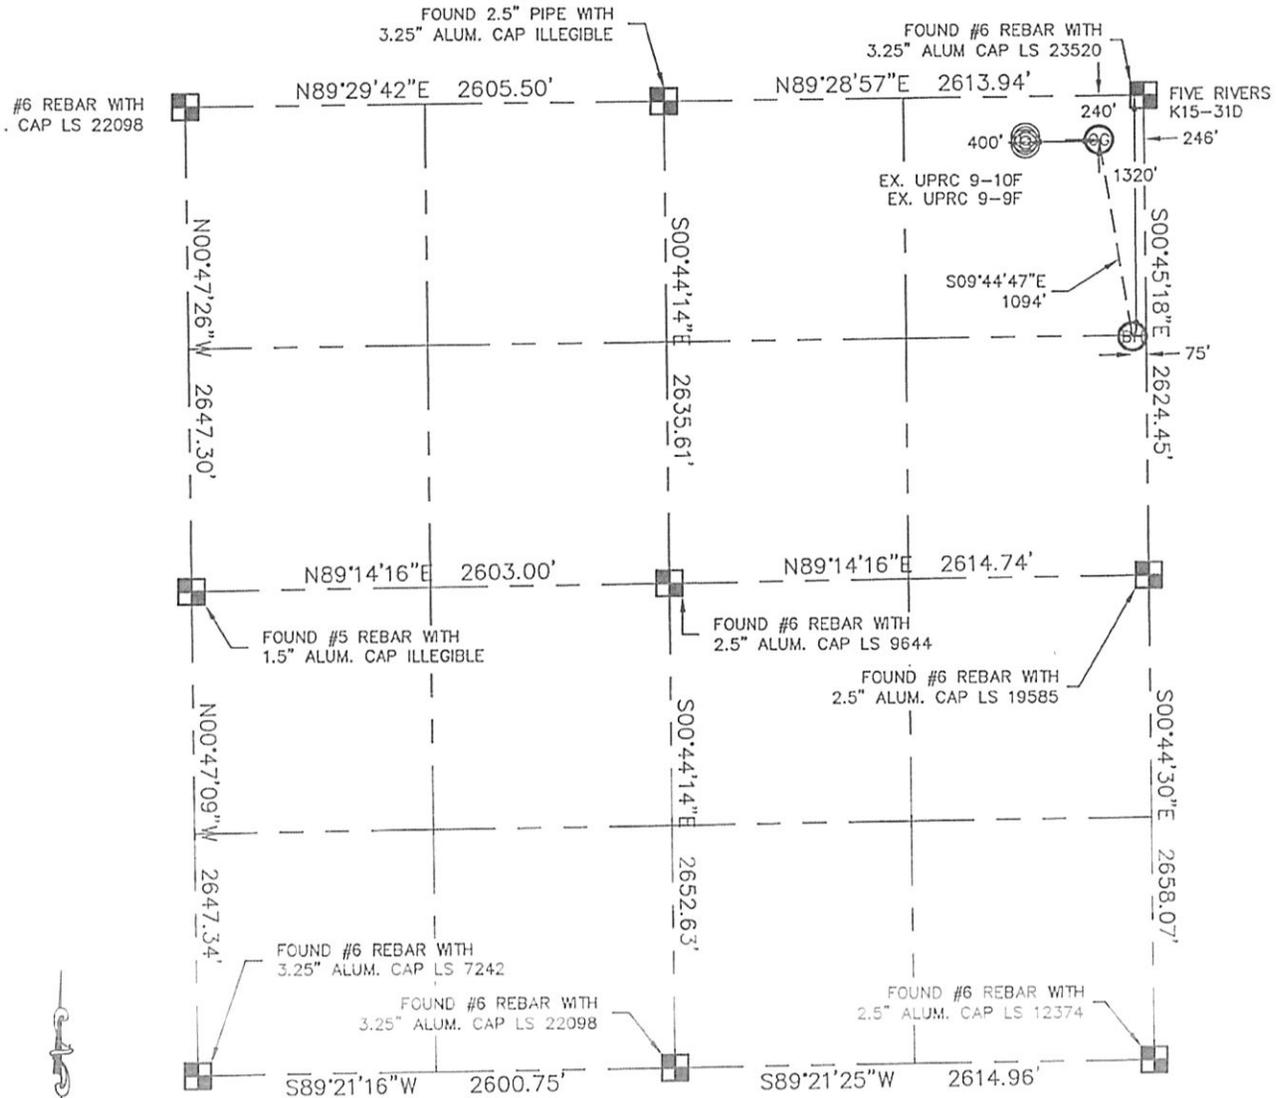

In accordance with a request from JOE MARTIN with Noble Energy Inc.

King Surveyors Inc. has determined the surface location of the FIVE RIVERS K15-31D to be 240' from the NORTH line and 246' from the EAST line and the bottom hole to be 1320' from the NORTH line and 75' from the EAST line, as measured at right angles, from the section lines of Section 16, Township 4 North, Range 66 West of the Sixth Principal Meridian, County of Weld, State of Colorado.

I hereby state that this Well Location Certificate was prepared by me, or under my direct supervision, that the fieldwork was completed on 5-3-10, for and on behalf of Noble Energy Inc. That this is not a Land Survey Plat or an Improvement Survey Plat, and that it is not to be relied upon for establishment of fence, building, or other future improvement lines.

NOTE:

- 1) Bearings shown are Grid Bearings of the Colorado State Plane Coordinate System, North Zone, North American Datum 1983/2007. The lineal dimensions as contained herein are based upon the "U.S. Survey Foot."
- 2) Ground elevations are based on an observed GPS elevation (NAVD 1988 DATUM).
- 3) NEAREST EXISTING WELL: UPRC 9-9F & UPRC 9-10F BOTH 400' WEST
- 4) IMPROVEMENTS: See VISIBLE IMPROVEMENTS exhibit for all visible improvements within 600' of well head.
- 5) SURFACE USE: CROP FIELD

SURFACE LOCATION
LATITUDE: 40.31827°N
LONGITUDE: 104.77413°W
PDOP: 1.2
ELEV: 4730'
1/4, 1/4: NE1/4NE1/4
NEAREST PROPERTY LINE: 240' NORTH

BOTTOM HOLE
LATITUDE: 40.31530°N
LONGITUDE: 104.77350°W

NOTE

According to Colorado law, you must commence any legal action based upon any defect in this W.L.C. within three years after you discover such defect. In no event, may any action based upon any defect in this survey be commenced more than ten years after the date of the certificate shown hereon. (13-80-105 C.R.S.)


LEGEND

-  = ALIQUOT MONUMENT AS DESCRIBED
-  = CALCULATED POSITION

5/11/2010



PROJECT#: 2010055

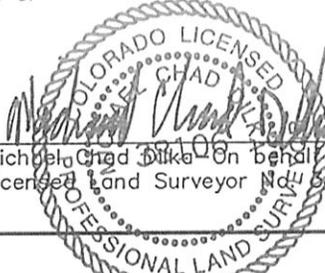

SITE SKETCH

SECTION: 16
TOWNSHIP: 4N
RANGE: 66W

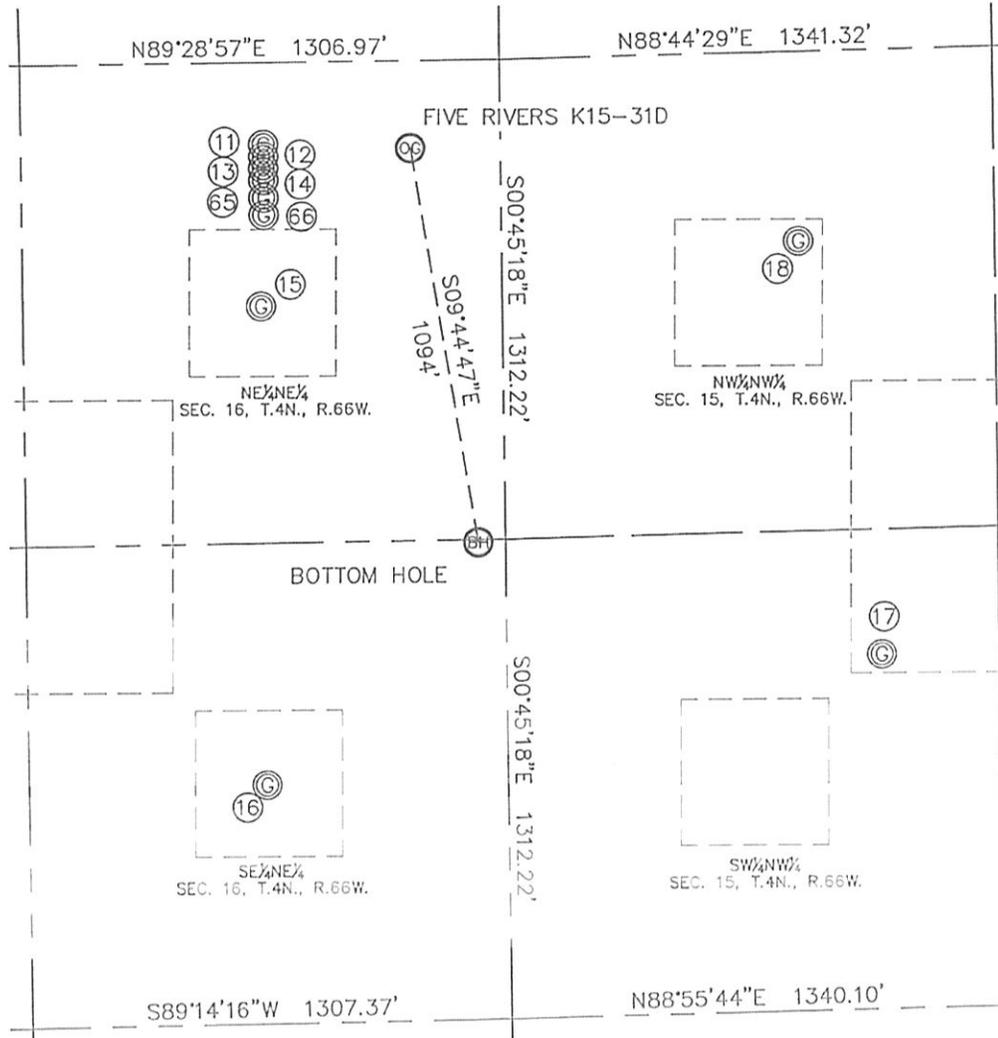

⑪

UPRC 9-10F
NE1/4NE1/4
225' FNL
645' FEL
LAT-40.31831'N
LONG-104.77556'W
PDOP: 1.4
ELEV: 4731'

⑫

UPRC 9-9F
NE1/4NE1/4
258' FNL
645' FEL
LAT-40.31822'N
LONG-104.77556'W
PDOP: 1.4
ELEV: 4731'

⑬

UPRC 9-15F
NE1/4NE1/4
290' FNL
646' FEL
LAT-40.31813'N
LONG-104.77556'W
PDOP: 1.2
ELEV: 4731'

⑭

UPRC 9-16F
NE1/4NE1/4
322' FNL
646' FEL
LAT-40.31804'N
LONG-104.77556'W
PDOP: 1.3
ELEV: 4731'

⑮

MONFORT GILCREST K 16-1
NE1/4NE1/4
666' FNL
657' FEL
LAT-40.31709'N
LONG-104.77560'W
PDOP: 1.2
ELEV: 4732'

⑯

MONFORT GILCREST K16-8
SE1/4NE1/4
1974' FNL
657' FEL
LAT-40.31350'N
LONG-104.77557'W
PDOP: 1.7
ELEV: 4736'

⑰

STEPHENS #1
SW1/4NW1/4
1656' FNL
1021' FWL
LAT-40.31442'N
LONG-104.76957'W
PDOP: 1.5
ELEV: 4736'

⑱

KAWATA 15-22
NW1/4NW1/4
520' FNL
808' FWL
LAT-40.31753'N
LONG-104.77035'W
PDOP: 1.7
ELEV: 4728'

⑲

FIVE RIVERS K09-23D
NE1/4NE1/4
370' FNL
646' FEL
LAT-40.31791'N
LONG-104.77556'W
PDOP: 1.1
ELEV: 4732'

⑳

FIVE RIVERS K16-27D
NE1/4NE1/4
417' FNL
646' FEL
LAT-40.31778'N
LONG-104.77556'W
PDOP: 1.1
ELEV: 4733'

