


WELL LOCATION CERTIFICATE

NW CRN SEC. 10
2" PIPE IN CONC.

SECTION 10, TOWNSHIP 4 NORTH, RANGE 67 WEST, 6TH P.M.

NE CRN SEC. 10
2.5" AC LS 24305

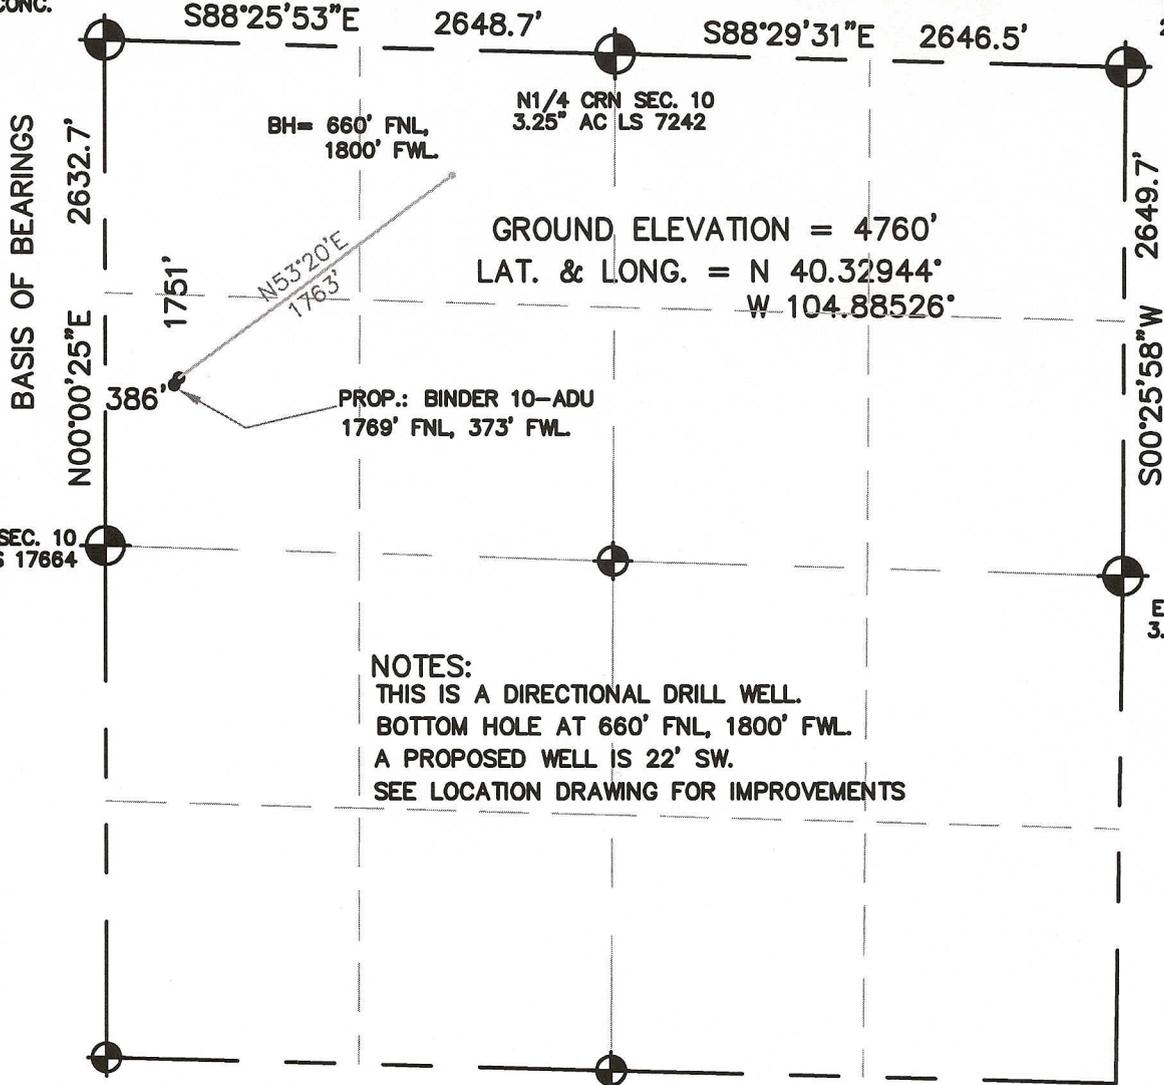

GROUND ELEVATION = 4760'
LAT. & LONG. = N 40.32944°
W 104.88526°

PROP.: BINDER 10-ADU

BH= 660' FNL,
1800' FWL

NOTES:
THIS IS A DIRECTIONAL DRILL WELL.
BOTTOM HOLE AT 660' FNL, 1800' FWL.
A PROPOSED WELL IS 22' SW.
SEE LOCATION DRAWING FOR IMPROVEMENTS


BASIS OF BEARINGS

I HEREBY STATE TO UNIOIL THAT THIS WELL LOCATION CERTIFICATE FOR THE WELL BINDER 21-10DU IS LOCATED 1751' FNL & 386' FWL, SEC. 10, T4N, R67W, 6PM.



LEGEND

- = FOUND MONUMENT
- = PROPOSED WELL
- = IMPROVEMENTS (AS LABELED)

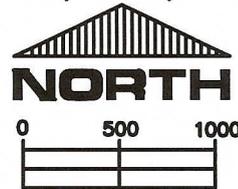

SCALE 1" = 1000'

ELEVATION SOURCE = USGS 7.5' QUAD.MAP CONTOURS
NGVD 1929 DATUM.

LAT. & LONG. ARE DIFFERENTIALLY CORRECTED (NAD'83)
USING (DGPS) WITH (PDOP) VALUES LESS THAN SIX (6).

SHOWN DISTANCES ARE FIELD MEASURED - EXTERIOR SECTION LINES
ARE DRAWN TO SCALE (BEST APPROX. OR FOUND MONUMENT).

DISTANCES TO WELL SHOWN PERPENDICULAR
TO SECTION LINES.

THOMAS G. CARLSON, PLS 24657
HORSESHOE SURVEYING, LLC

THIS IS NOT A MONUMENTED BOUNDARY SURVEY, IT IS ONLY A
DRAWING INTENDED TO DEPICT THE WELL LOCATION TO SECTION LINES.

PREPARED BY: HORSESHOE SURVEYING, LLC PO BOX 150458 LAKEWOOD, CO 80215 (720)872-0196		WELL NAME: BINDER 21-10DU	
DRAWING DATE: 9-8-10		LOCATION: WELD COUNTY, CO SWNW, SEC. 10, T4N, R67W, 6TH P.M.	
FIELD DATE: 10-31-08	BY: TGC	CHKD:	JOB NO.
		SHEET NO. 1 OF 1	