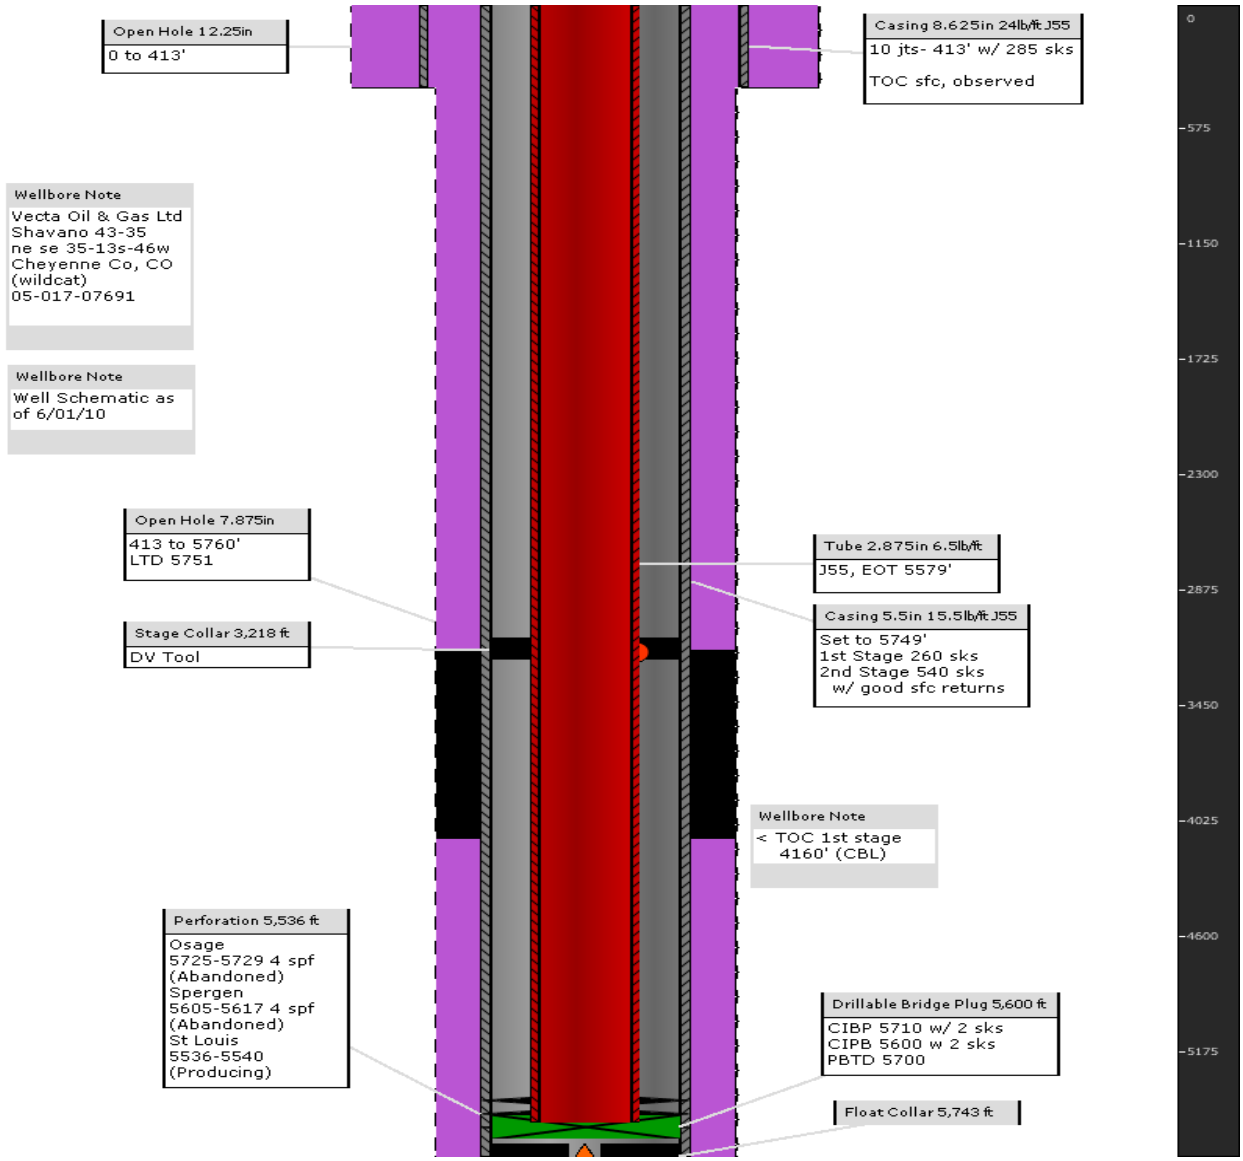

Measured Depth - 5749 ft

Legend:

- Float Collar
- Stage Collar
- Open Hole
- Tubing
- Drillable Bridge Plug
- Casing
- Perforation