

Job: 10061 Kerry #2

Inv # 1299



High Prairie Surveying of Kiowa, Colorado has in accordance with a request from **Jack Fincham, Wiepking Fullerton Energy** has determined the location of **Kerry #2** to be **620 feet FSL**, and **620 feet FWL**, (90° off Section lines) of **SECTION 20**, Township **10s**, Range **55w** of the 6th Principal Meridian, **Lincoln County**, Colorado.

Date: Staked on 10-01-10 drawn on 10-07-10.

**Re:** Staked by Keith Westfall

**Drawn:** Drawn by Elijah Frane

## Reference Area

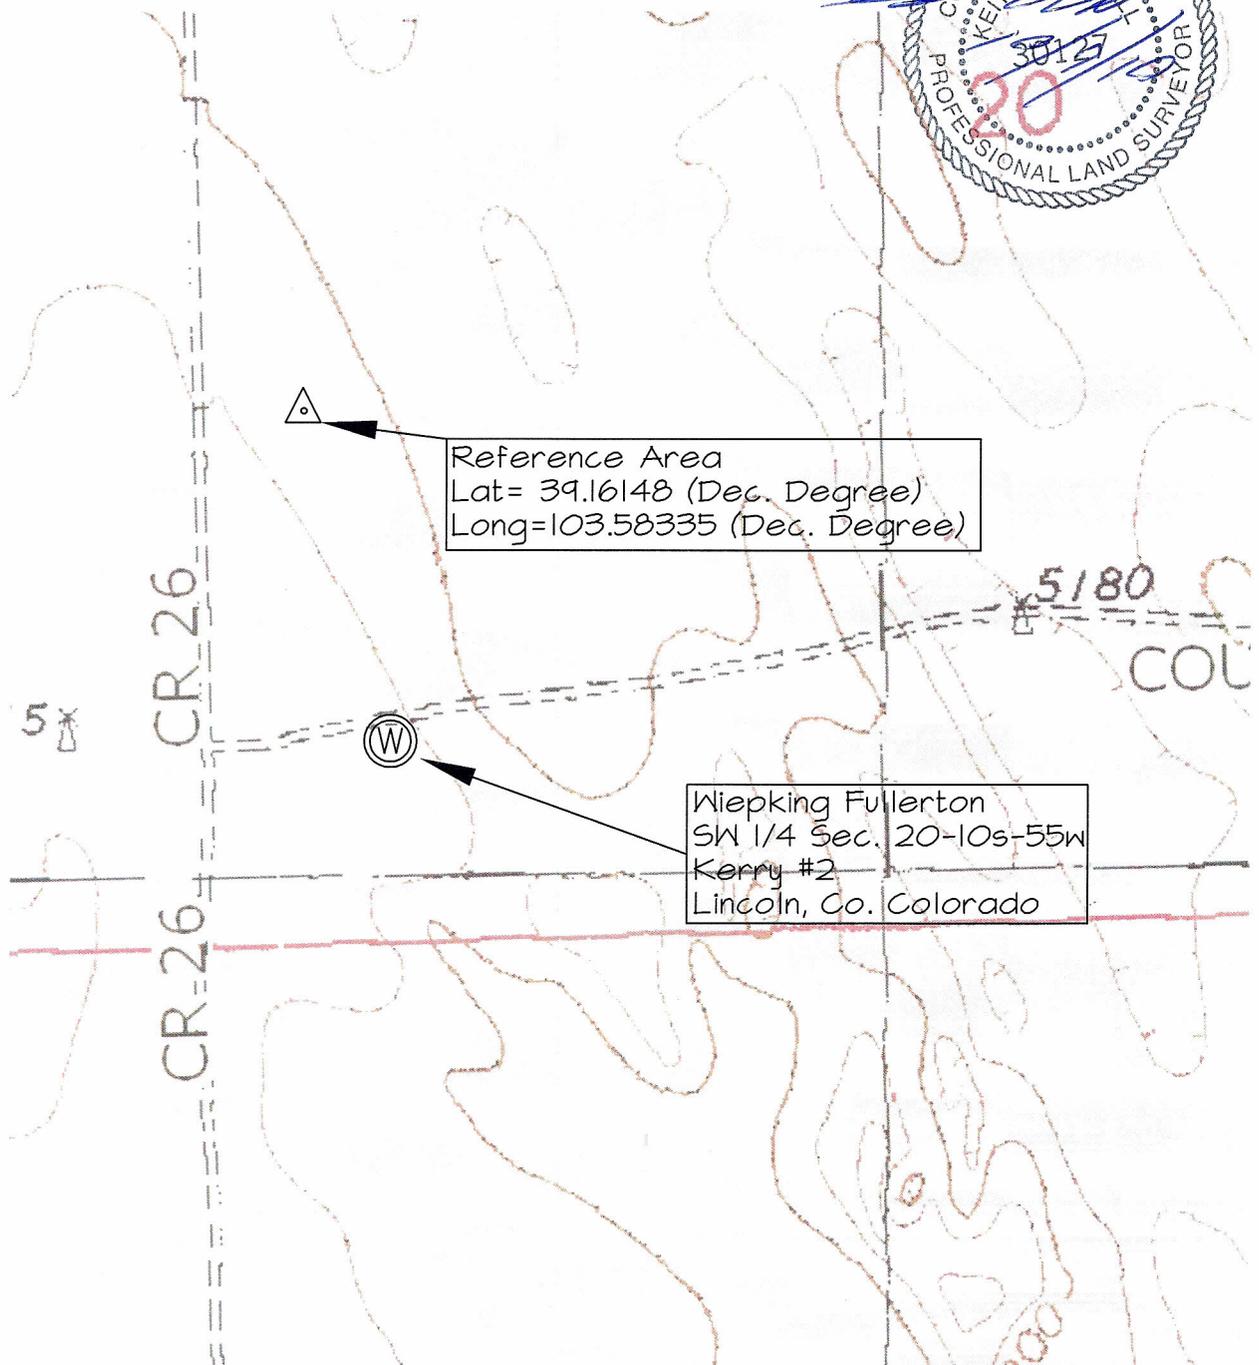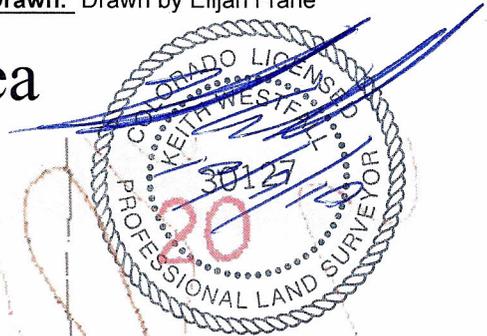

Reference Area  
Lat= 39.16148 (Dec. Degree)  
Long=103.58335 (Dec. Degree)

Wiepking Fullerton  
SW 1/4 Sec. 20-10s-55w  
Kerry #2  
Lincoln, Co. Colorado