


# Arapaho-State 6-81-36-3 Location Map

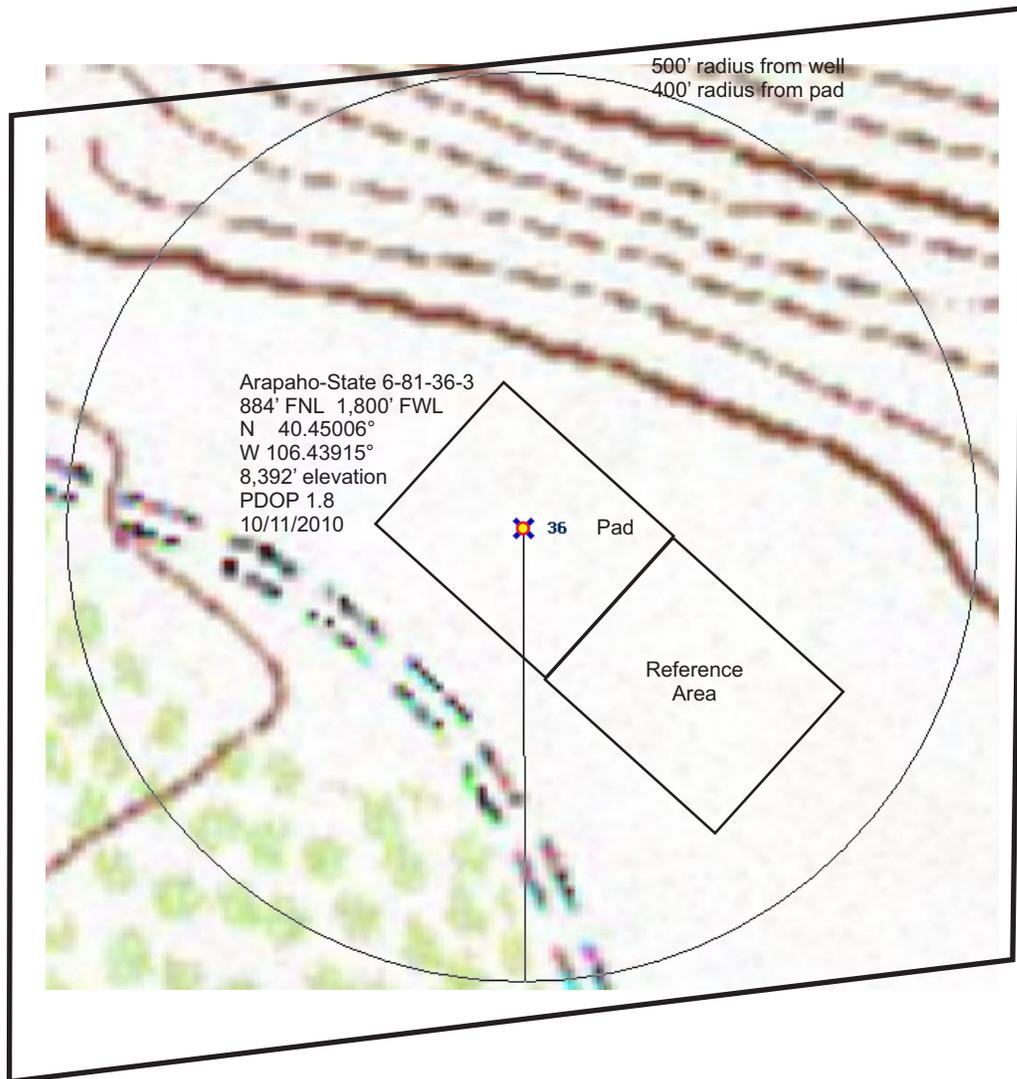

There is a ranch driveway with ditches between location and creek.  
There are no other improvements within 500 feet of the location.