



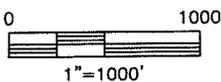

WELL LOCATION CERTIFICATE

THIS MAP DOES NOT REPRESENT A BOUNDARY SURVEY

SECTION: 12
TOWNSHIP: 6N
RANGE: 67W

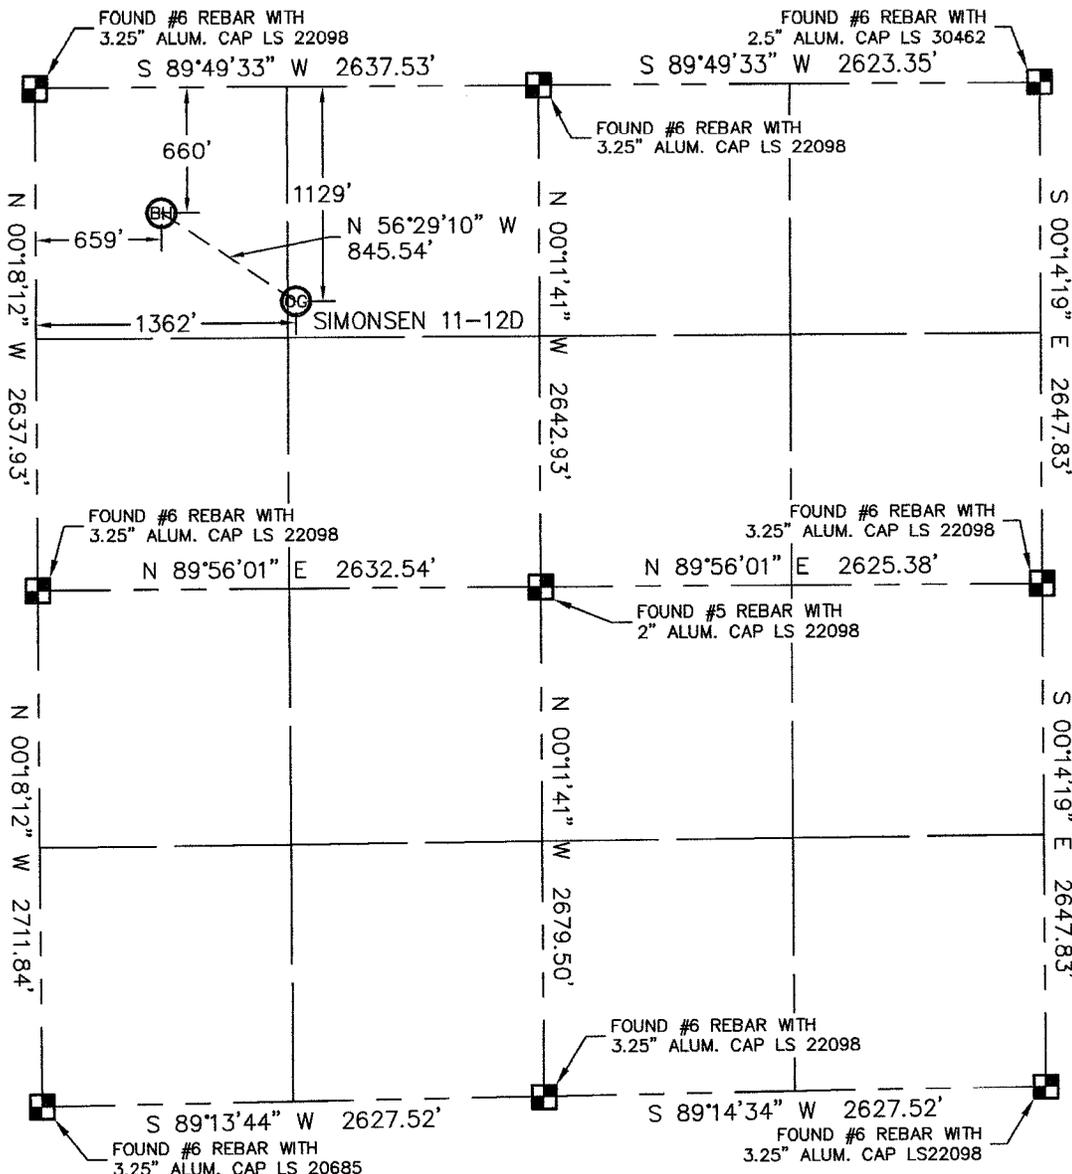


In accordance with a request from AL BRAGG with Petroleum Development Corporation Lat40°, LLC has determined the surface location of the SIMONSEN 11-12D to be 1129' from the NORTH line and 1362' from the WEST line and the bottom hole to be 660' from the NORTH line and 659' from the WEST line as measured at right angles from the section lines of Section 12, Township 6 North, Range 67 West of the Sixth Principal Meridian, Town of Severance, County of Weld, State of Colorado.

I hereby state that this Well Location Certificate was prepared by me, or under my direct supervision, that the fieldwork was completed on 10/13/10, for and on behalf of Petroleum Development Corporation That this is not a Land Survey Plat or an Improvement Survey Plat, and that it is not to be relied upon for establishment of fence, building, or other future improvement lines.

NOTE:

- 1) Bearings shown are Grid Bearings of the Colorado State Plane Coordinate System, North Zone, North American Datum 1983/2007. The lineal dimensions as contained herein are based upon the "U.S. Survey Foot."
- 2) Ground elevations are based on an observed GPS elevation (NAVD 1988 DATUM).
- 3) IMPROVEMENTS: See LOCATION DRAWING exhibit for all visible improvements within 400' of disturbed area.
- 4) SURFACE USE: IRRIGATED CROP FIELD
- 5) INSTRUMENT OPERATOR: BRIAN BRINKMAN

SURFACE LOCATION	BOTTOM HOLE
LATITUDE: 40.50585°N	LATITUDE: 40.50715°N
LONGITUDE: 104.84632°W	LONGITUDE: 104.84884°W
PDOP: 0.9	
ELEV: 4864	
1/4, 1/4: NE1/4NW1/4	
NEAREST PROPERTY LINE: 1129' NORTH	

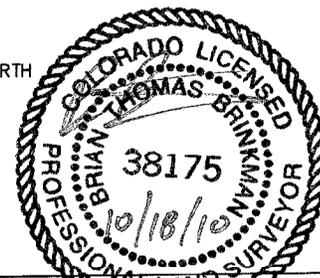

NOTE

According to Colorado law, you must commence any legal action based upon any defect in this W.L.C. within three years after you discover such defect. In no event, may any action based upon any defect in this survey be commenced more than ten years after the date of the certificate shown hereon. (13-80-105 C.R.S.)

LEGEND

- = ALIQUOT MONUMENT AS DESCRIBED
- = CALCULATED POSITION

Brian T. Brinkman—On behalf of Lat40°, LLC
 Colorado Licensed Professional
 Land Surveyor No. 38175 PROJECT#: 2010056