


WELL LOCATION CERTIFICATE

THIS MAP DOES NOT REPRESENT A BOUNDARY SURVEY

SECTION: 22
TOWNSHIP: 2N
RANGE: 65W

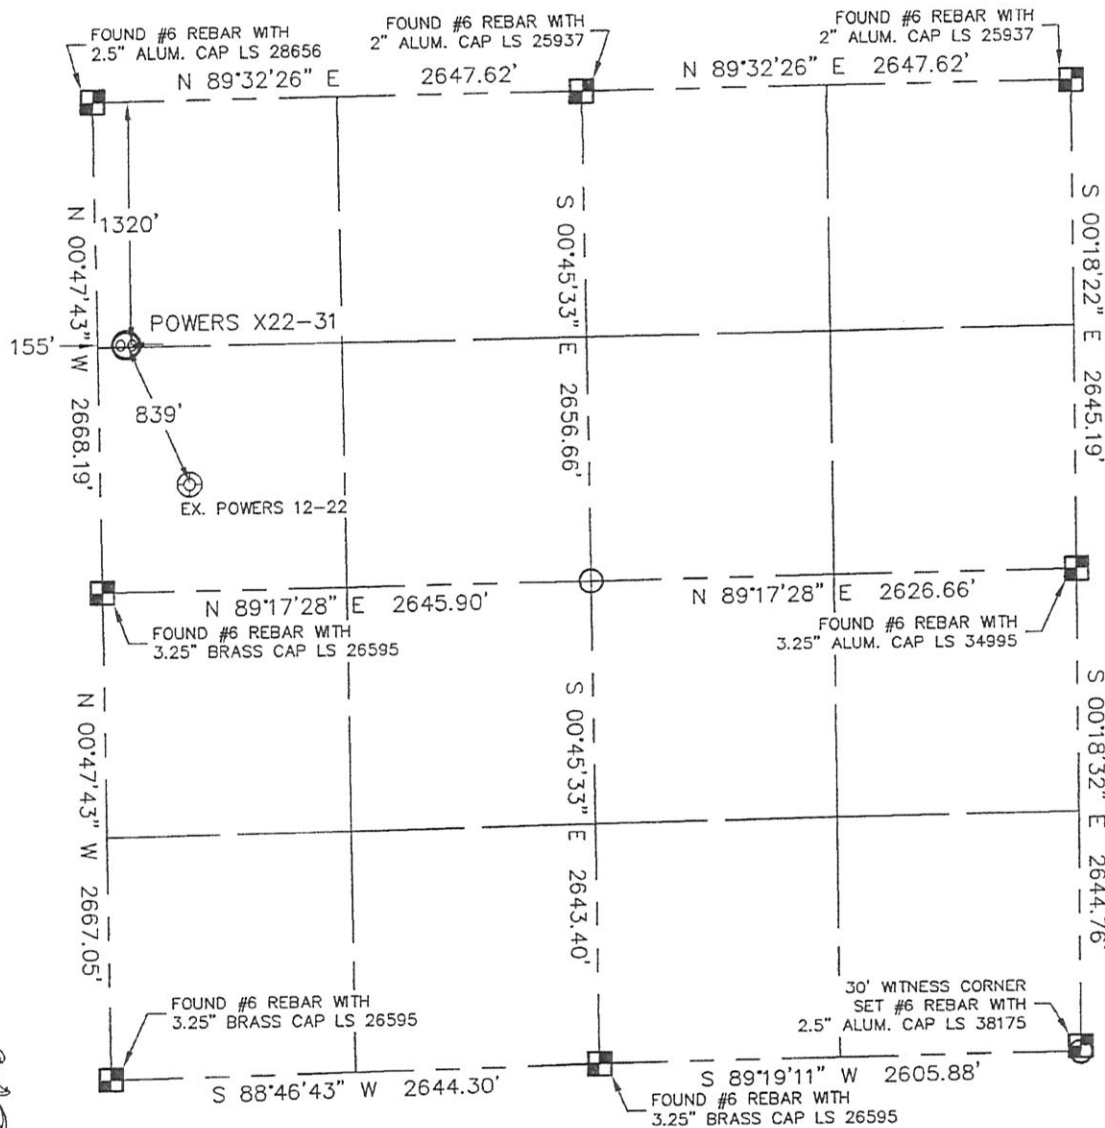

In accordance with a request from Mike Rodine with Noble Energy Inc. Lat40°, LLC has determined the surface location of the POWERS X22-31 to be 1320' from the NORTH line and 155' from the WEST line as measured at right angles from the section line of Section 22, Township 2 North, Range 65 West of the Sixth Principal Meridian, County of Weld, State of Colorado.

I hereby state that this Well Location Certificate was prepared by me, or under my direct supervision, that the fieldwork was completed on 7/26/10, for and on behalf of Noble Energy Inc. That this is not a Land Survey Plat or an Improvement Survey Plat, and that it is not to be relied upon for establishment of fence, building, or other future improvement lines.

NOTE:

- 1) Bearings shown are Grid Bearings of the Colorado State Plane Coordinate System, North Zone, North American Datum 1983/2007. The lineal dimensions as contained herein are based upon the "U.S. Survey Foot."
- 2) Ground elevations are based on an observed GPS elevation (NAVD 1988 DATUM).
- 3) NEAREST EXISTING WELL: POWERS 12-22 839'
- 4) IMPROVEMENTS: See LOCATION DRAWING exhibit for all visible improvements within 400' of disturbed area.
- 5) SURFACE USE: RANGELAND
- 6) INSTRUMENT OPERATOR: BRIAN BRINKMAN

SURFACE LOCATION
LATITUDE: 40.127777N
LONGITUDE: 104.659000W
PDOP: 2.7
ELEV: 4882
1/4, 1/4: NW1/4NW1/4
NEAREST PROPERTY LINE: 155' WEST



Brian T. Brinkman—On behalf of Lat40°, LLC
Colorado Licensed Professional
Land Surveyor No. 38175 PROJECT#: 2010052

LEGEND


- = ALIQUOT MONUMENT AS DESCRIBED
- = CALCULATED POSITION

NOTE

According to Colorado law, you must commence any legal action based upon any defect in this W.L.C. within three years after you discover such defect. In no event, may any action based upon any defect in this survey be commenced more than ten years after the date of the certificate shown hereon. (13-80-105 C.R.S.)

SITE SKETCH

SECTION: 22
TOWNSHIP: 2N
RANGE: 65W

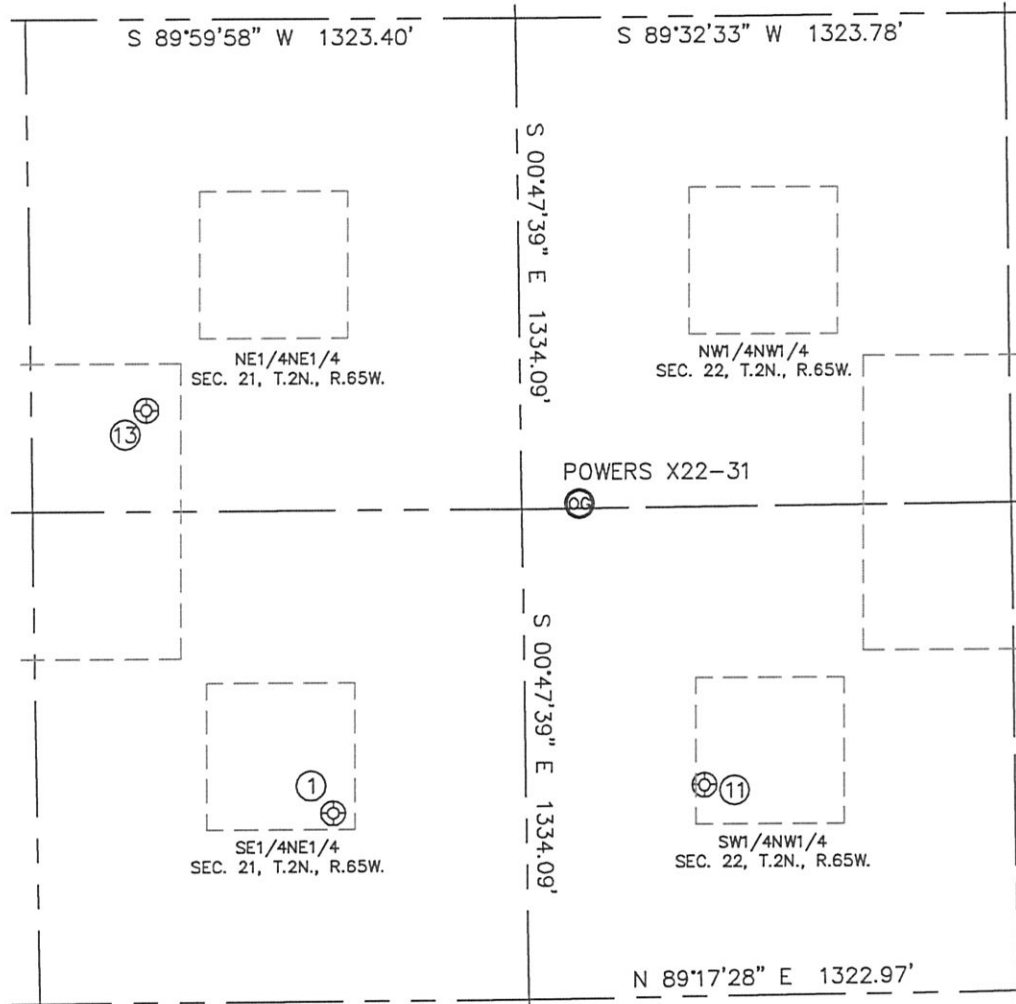

①
ARENDS X21-8
SE1/4NE1/4
2158' FNL
523' FEL
LAT-40.12549°N
LONG-104.66141°W
PDOP: 2.0
ELEV: 4889

⑪
POWERS 12-22
SW1/4NW1/4
2090' FNL
483' FWL
LAT-40.12566°N
LONG-104.65781°W
PDOP: 1.7
ELEV: 4882

⑬
HALLER 41-21
NE1/4NE1/4
1062' FNL
1012' FEL
LAT-40.12851°N
LONG-104.66317°W
PDOP: 1.5
ELEV: 4884

