
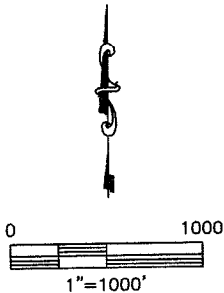


WELL LOCATION CERTIFICATE

THIS MAP DOES NOT REPRESENT A BOUNDARY SURVEY

SECTION: 12
TOWNSHIP: 6N
RANGE: 67W

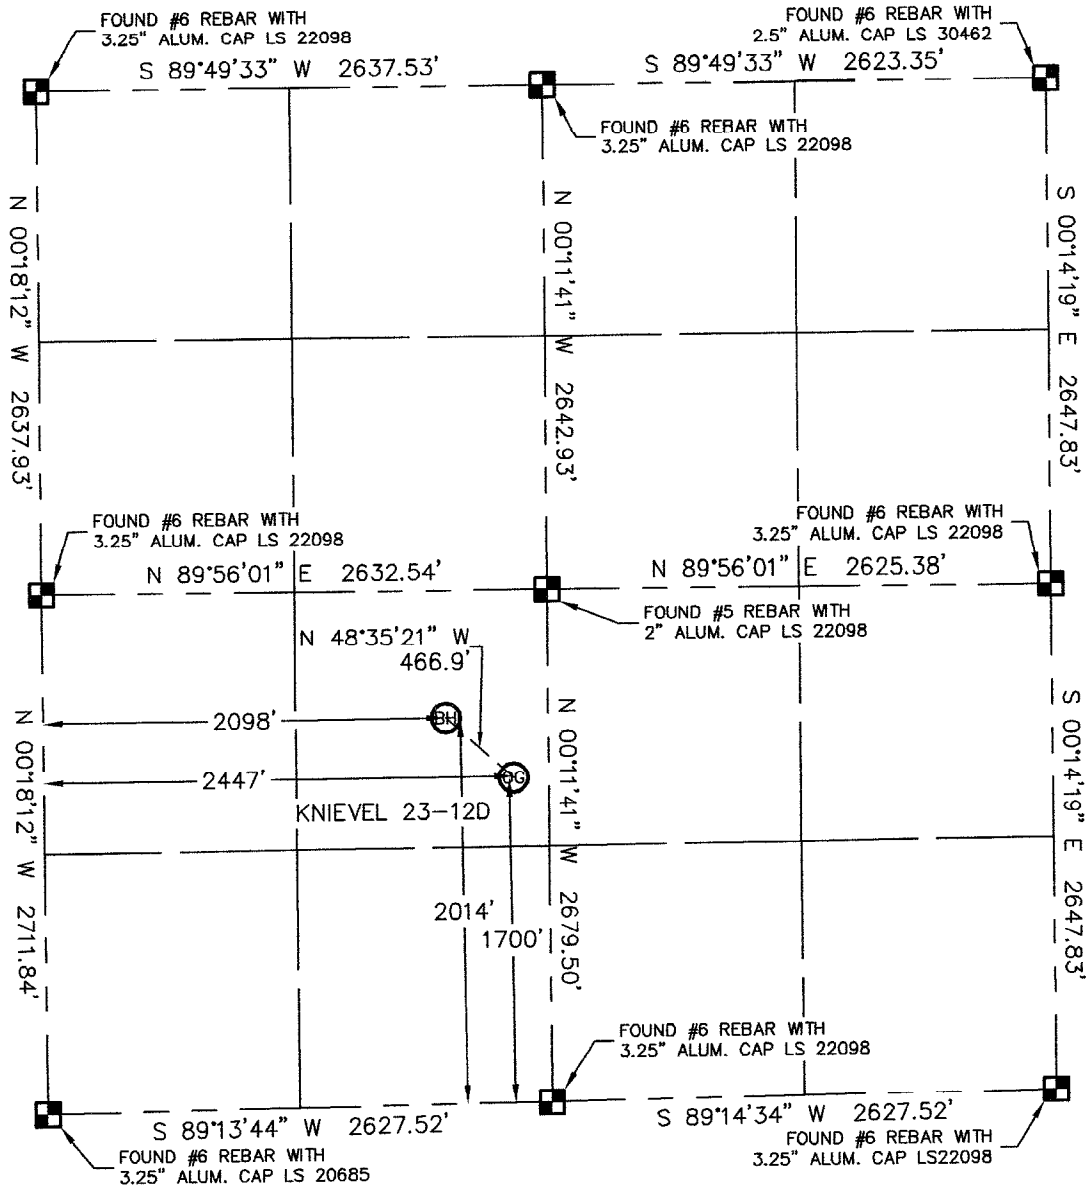

In accordance with a request from AL BRAGG with Petroleum Development Corporation Lat40', LLC has determined the surface location of the KNEVEL 23-12D to be 1700' from the SOUTH line and 2447' from the WEST line and the bottom hole to be 2014' from the SOUTH line and 2098' from the WEST line as measured at right angles from the section line of Section 12, Township 6 North, Range 67 West of the Sixth Principal Meridian, County of Weld, State of Colorado.

I hereby state that this Well Location Certificate was prepared by me, or under my direct supervision, that the fieldwork was completed on 9/12/10, for and on behalf of Petroleum Development Corporation. That this is not a Land Survey Plat or an Improvement Survey Plat, and that it is not to be relied upon for establishment of fence, building, or other future improvement lines.

NOTE:

- NOTE:
- 1) Bearings shown are Grid Bearings of the Colorado State Plane Coordinate System, North Zone, North American Datum 1983/2007. The lineal dimensions as contained herein are based upon the "U.S. Survey Foot."
 - 2) Ground elevations are based on an observed GPS elevation (NAVD 1988 DATUM).
 - 3) IMPROVEMENTS: See LOCATION DRAWING exhibit for all visible improvements within 400' of disturbed area.
 - 4) SURFACE USE: IRRIGATED CROP FIELD
 - 5) INSTRUMENT OPERATOR: BRIAN BRINKMAN

SURFACE LOCATION
LATITUDE: 40.49899°N
LONGITUDE: 104.84244°W
PDOP: 1.3
ELEV: 4866
1/4,1/4: NE1/4SW1/4
NEAREST PROPERTY LINE


 
BOTTOM HOLE
LATITUDE: 40.49985°N
LONGITUDE: 104.84369°W

1/4, 1/4: NE1/4SW1/4
NEAREST PROPERTY LINE: 184' EAST

NOTE

NOTE
According to Colorado law, you must commence any legal action based upon any defect in this W.L.C. within three years after you discover such defect. In no event, may any action based upon any defect in this survey be commenced more than ten years after the date of the certificate shown hereon. (13-80-105 C.R.S.)

LEGEND

-  = ALIQUOT MONUMENT AS DESCRIBED
 = CALCULATED POSITION

Brian T. Brinkman—On behalf of LAND 46, LLC
Colorado Licensed Professional
Land Surveyor No. 38175 PROJECT#: 2010056

