


Lat40°, LLC 1635 Foxtrail Drive, Suite 325 Loveland, CO 80538

WELL LOCATION CERTIFICATE

SECTION: 15&16
TOWNSHIP: 5N
RANGE: 64W

THIS MAP DOES NOT REPRESENT A BOUNDARY SURVEY

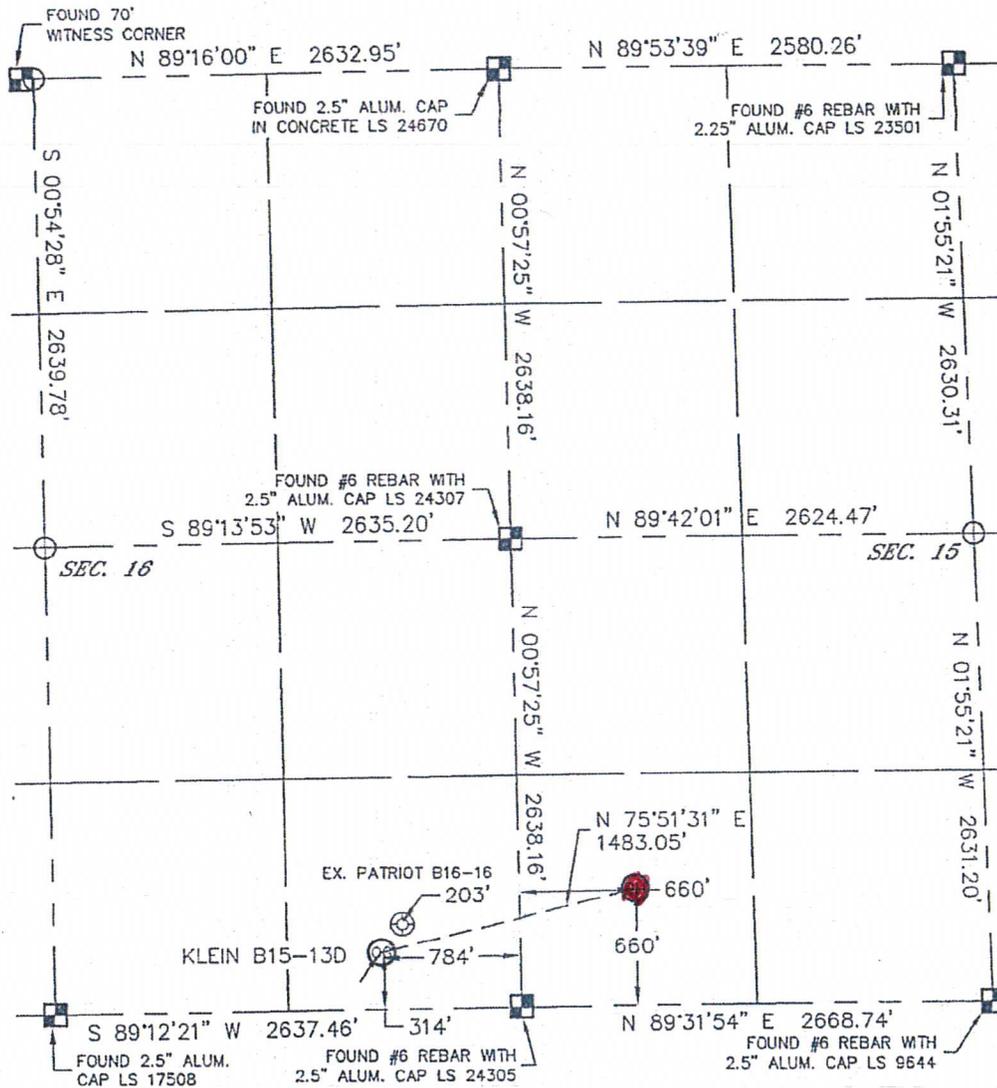

In accordance with a request from Roger Lowe with Noble Energy Inc. Lat40°, LLC has determined the surface location of the KLEIN B15-13D to be 314' from the SOUTH line and 784' from the EAST line as measured at right angles from the section line of Section 16, Township 5 North, Range 64 West and the bottom hole to be 660' from the SOUTH line and 660' from the WEST line of Section 15, Township 5 North, Range 64 West of the Sixth Principal Meridian, County of Weld, State of Colorado.


I hereby state that this Well Location Certificate was prepared by me, or under my direct supervision, that the fieldwork was completed on 8-25-10, for and on behalf of Noble Energy Inc. That this is not a Land Survey Plat or an Improvement Survey Plat, and that it is not to be relied upon for establishment of fence, building, or other future improvement lines.

NOTE:

- 1) Bearings shown are Grid Bearings of the Colorado State Plane Coordinate System, North Zone, North American Datum 1983/2007. The lineal dimensions as contained herein are based upon the "U.S. Survey Foot."
- 2) Ground elevations are based on an observed GPS elevation (NAVD 1988 DATUM).
- 3) NEAREST EXISTING WELL: PATRIOT B16-16 203'
- 4) IMPROVEMENTS: See LOCATION DRAWING exhibit for all visible improvements within 400' of disturbed area.
- 5) SURFACE USE: RANGELAND
- 6) INSTRUMENT OPERATOR: BRIAN BRINKMAN

SURFACE LOCATION
LATITUDE: 40.392967N
LONGITUDE: 104.548297W
PDOP: 2.0
ELEV: 4607
1/4, 1/4: SE1/4SE1/4
NEAREST PROPERTY LINE: 249' EAST

BOTTOM HOLE
LATITUDE: 40.393917N
LONGITUDE: 104.543117W

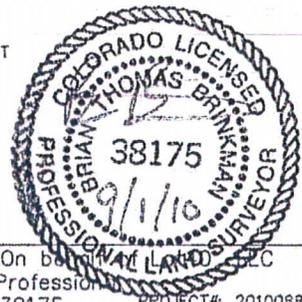

NOTE

According to Colorado law, you must commence any legal action based upon any defect in this W.L.C. within three years after you discover such defect. In no event, may any action based upon any defect in this survey be commenced more than ten years after the date of the certificate shown hereon. (13-80-105 C.R.S.)

LEGEND


-  = ALIQUOT MONUMENT AS DESCRIBED
-  = CALCULATED POSITION

Brian T. Brinkman—On behalf of
Colorado Licensed Professional Land Surveyor No. 38175
PROJECT#: 2010088

SITE SKETCH

KLEIN B15-13D

SECTION: 15&16
TOWNSHIP: 5N
RANGE: 64W

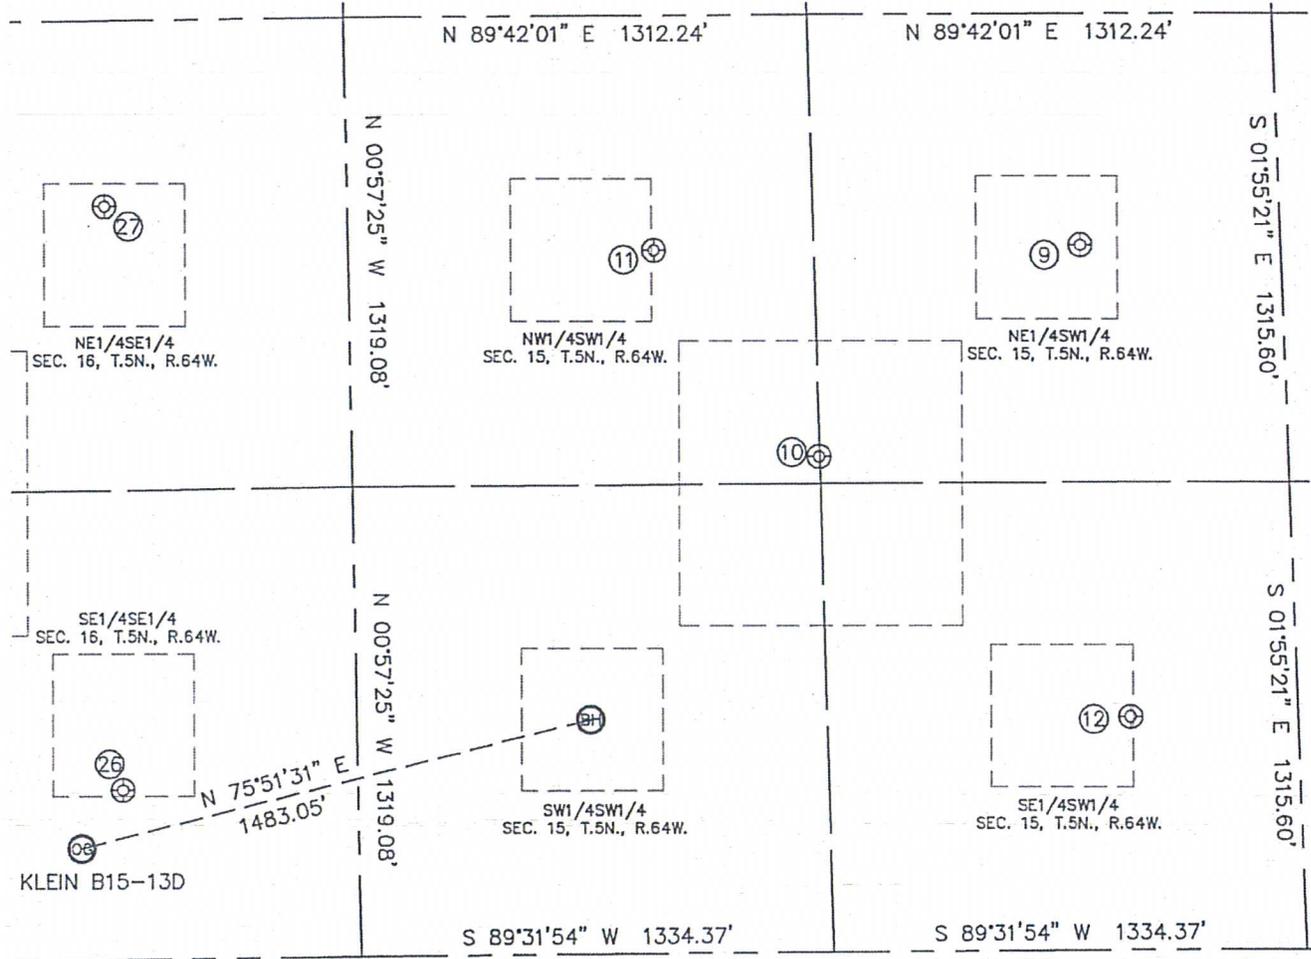

⑨
LOUSTELET B15-11
NE1/4SW1/4
1981' FSL
2072' FWL
LAT-40.39753N
LONG-104.53807W
PDOP:1.5
ELEV: 4576

⑩
FRENZEL B15-25
NW1/4SW1/4
1393' FSL
1321' FWL
LAT-40.39592N
LONG-104.54075W
PDOP:1.8
ELEV: 4577

⑪
LOUSTALET 15-1
NW1/4SW1/4
1976' FSL
865' FWL
LAT-40.39752N
LONG-104.54240W
PDOP:1.8
ELEV: 4579

⑫
LOUSTALET B15-14
SE1/4SW1/4
656' FSL
2186' FWL
LAT-40.39389N
LONG-104.53764W
PDOP:1.8
ELEV: 4574

⑳
PATRIOT B16-16
SE1/4SE1/4
477' FSL
664' FEL
LAT-40.39341N
LONG-104.54786W
PDOP:2.4
ELEV: 4609

㉑
PATRIOT B16-9
NE1/4SE1/4
2116' FSL
685' FEL
LAT-40.39791N
LONG-104.54797W
PDOP:2.0
ELEV: 4607

