

Steil Surveying Services, LLC


1102 West 19th Street P.O. BOX 2073

Cheyenne, Wyoming 82009

# WELL LOCATION CERTIFICATE

THIS MAP DOES NOT REPRESENT A BOUNDARY SURVEY

SECTION 27  
TOWNSHIP 7 NORTH  
RANGE 64 WEST

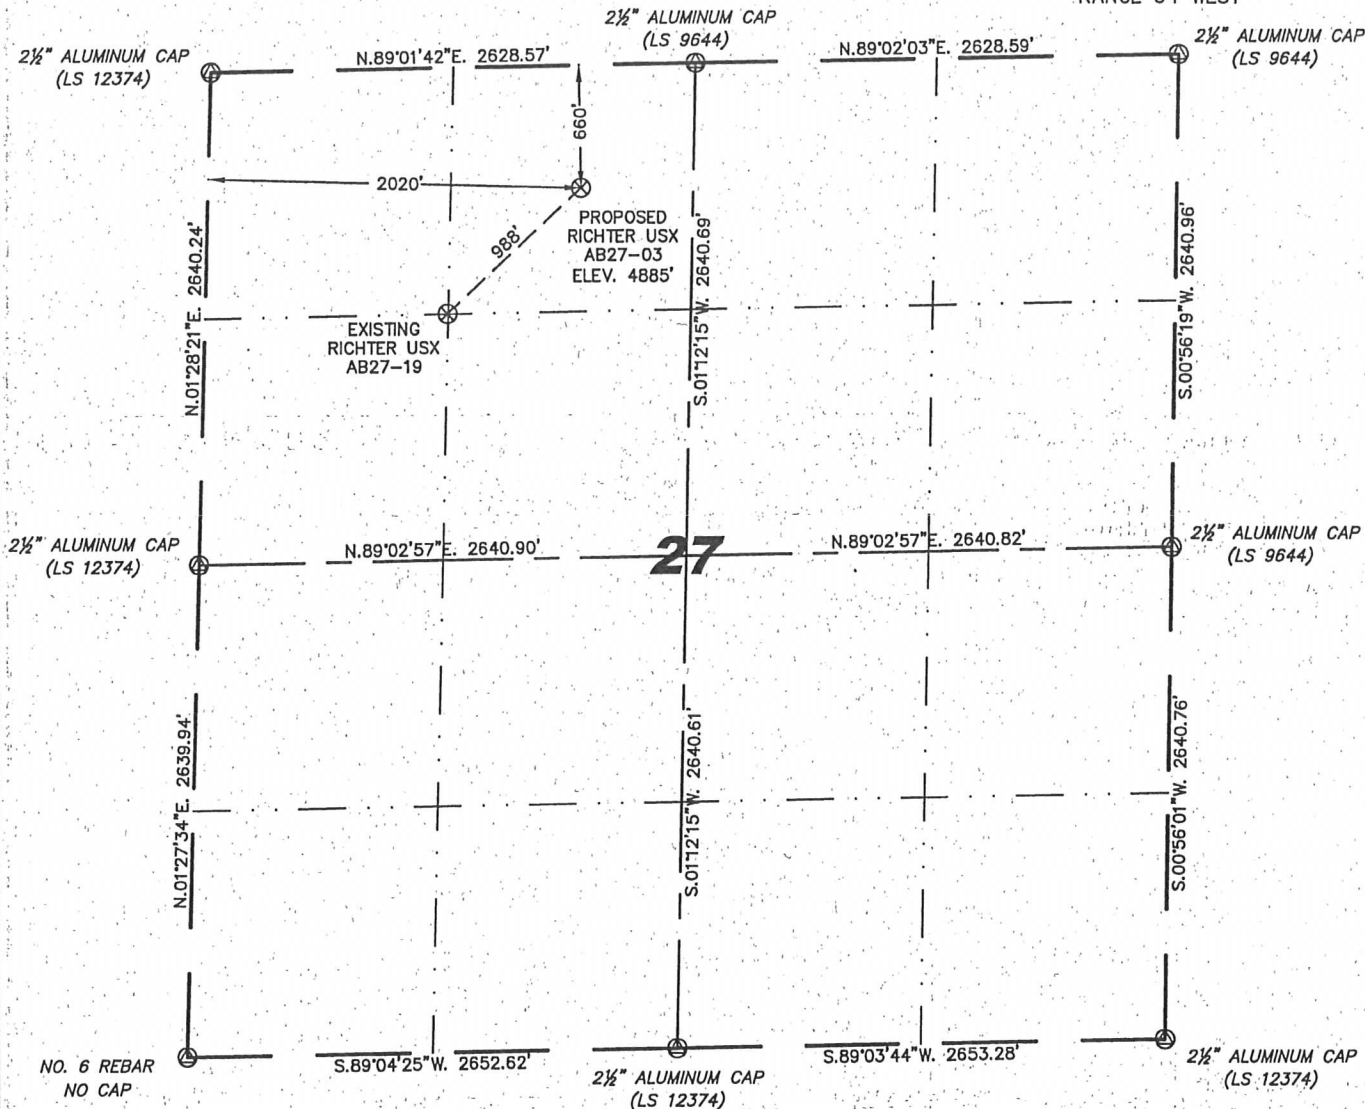

IN ACCORDANCE WITH A REQUEST FROM BEAU FRITZ - NOBLE ENERGY INC, STEIL SURVEYING SERVICES, LLC HAS DETERMINED THE LOCATION OF THE RICHTER USX AB27-03 WELL TO BE 660' FNL, 2020' FWL, AS MEASURED AT NINETY (90) DEGREES FROM THE SECTION LINES, SECTION 27, TOWNSHIP 7 NORTH, RANGE 64 WEST, 6TH PRINCIPLE MERIDIAN, WELD COUNTY, COLORADO.

I HEREBY CERTIFY THAT THIS WELL LOCATION CERTIFICATE WAS PREPARED BY ME, OR UNDER MY DIRECT SUPERVISION, THAT THE FIELD WORK WAS COMPLETED ON 09/23/2010, FOR AND ON BEHALF OF NOBLE ENERGY INC, THAT IT IS NOT A LAND SURVEY PLAT OR AN IMPROVEMENT SURVEY PLAT, AND THAT IT IS NOT TO BE RELIED UPON FOR ESTABLISHMENT OF FENCE, BUILDING, OR OTHER FUTURE IMPROVEMENT LINES.

## NOTES:

- 1) BASIS OF BEARINGS FOR THIS MAP ARE BASED UPON GPS OBSERVATIONS MADE ON 09/26/2009 BETWEEN MONUMENTS LOCATED AT THE SOUTHEAST SECTION CORNER AND THE NORTHEAST SECTION CORNER OF SAID SECTION AND WITH ALL BEARINGS SHOWN HEREON RELATIVE THERETO.
- 2) COORDINATES SHOWN ARE COLORADO STATE PLANE (NORTH ZONE) NAD 83.
- 3) ELEVATIONS ARE BASED UPON NGS OPUS SOLUTION NAVD 88-DATUM.
- 4) THE NEAREST EXISTING WELL IS: RICHTER USX AB27-19, 988' SOUTHWEST.
- 5) SEE VISIBLE IMPROVEMENTS EXHIBIT FOR ALL IMPROVEMENTS WITHIN 600'.
- 6) THE LOCATION FALLS IN CROP LAND.

## LATITUDE & LONGITUDE (NAD 83 SURFACE HOLE):

LATITUDE: N 40.54965°  
LONGITUDE: W 104.53796°  
PDOP: 2.0  
QUARTER-QUARTER: NE/4NW/4  
NEAREST PROPERTY LINE: 609' TO THE EAST

## LEGEND

- (A) FOUND SURVEY MONUMENT PER MONUMENT RECORD - EXCEPTIONS NOTED.
- (C) CALCULATED DIMENSION

NOTICE: According to Colorado law you MUST commence any legal action based upon any defect in this W.L.C. within three years after you first discover such defect. In no event may any action based upon any defect in this W.L.C. be commenced more than ten years from this sold date of the certification shown hereon.

David C. Holmes  
Professional Land Surveyor Registration No. 32828  
State of Colorado


JOB #: 10086

Completed 09/27/2010



# SKETCH – RICHTER USX AB27-03

SECTION 27  
TOWNSHIP 7 NORTH  
RANGE 64 WEST

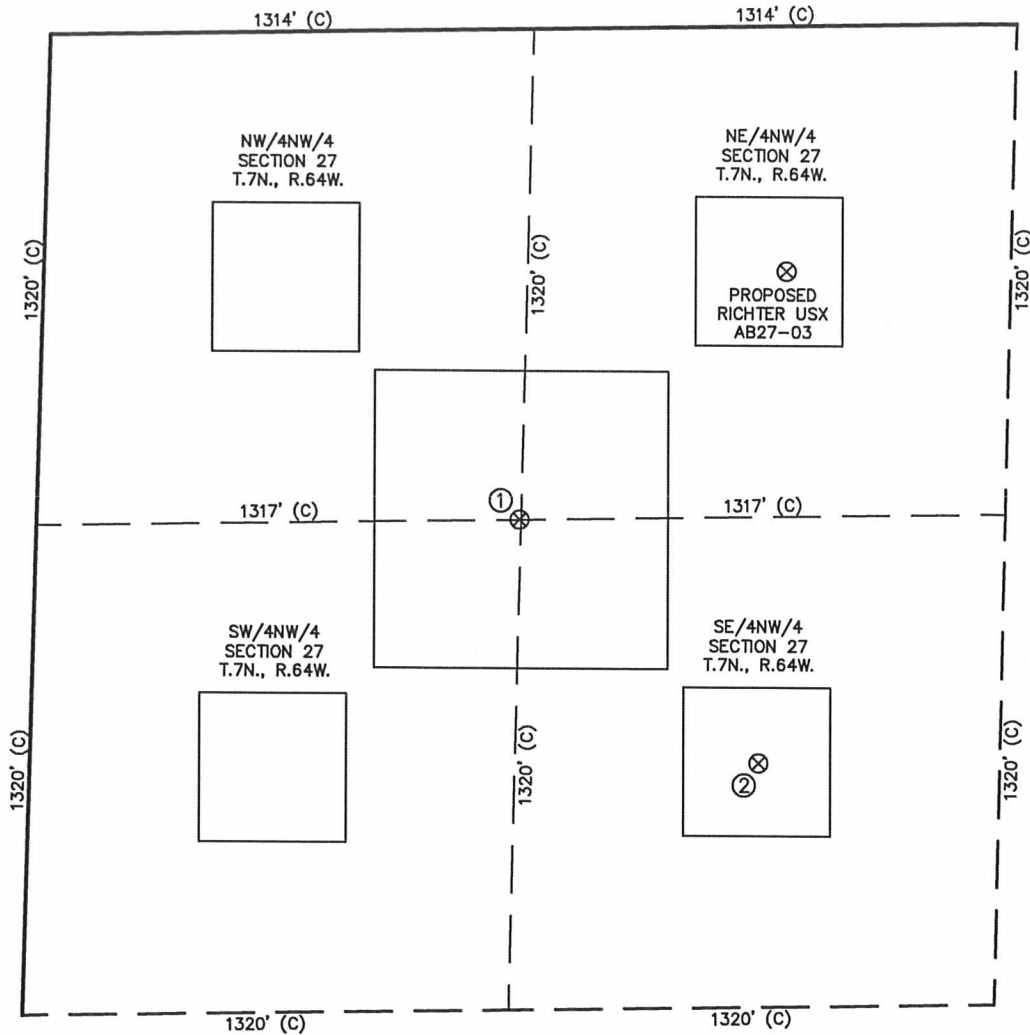

①

RICHTER USX  
AB27-19  
NW/NW SEC. 27  
1319' FNL  
1312' FWL  
EL 4905'  
N 40.54783  
W 104.54060  
PDOP 2.8

②

RICHTER USX  
AB27-6  
SE/NW SEC. 27  
1982' FNL  
1981' FWL  
EL 4900'  
N 40.54602  
W 104.53828  
PDOP 2.3

## NOTES:

- 1) THIS SKETCH DOES NOT REPRESENT A BOUNDARY SURVEY.
- 2) THE DATUM FOR THE LATITUDES AND LONGITUDES ON THIS SKETCH IS NAD83.



0 500

Scale: 1" = 500'