


# SCHNEIDER ENERGY SERVICES, INC.

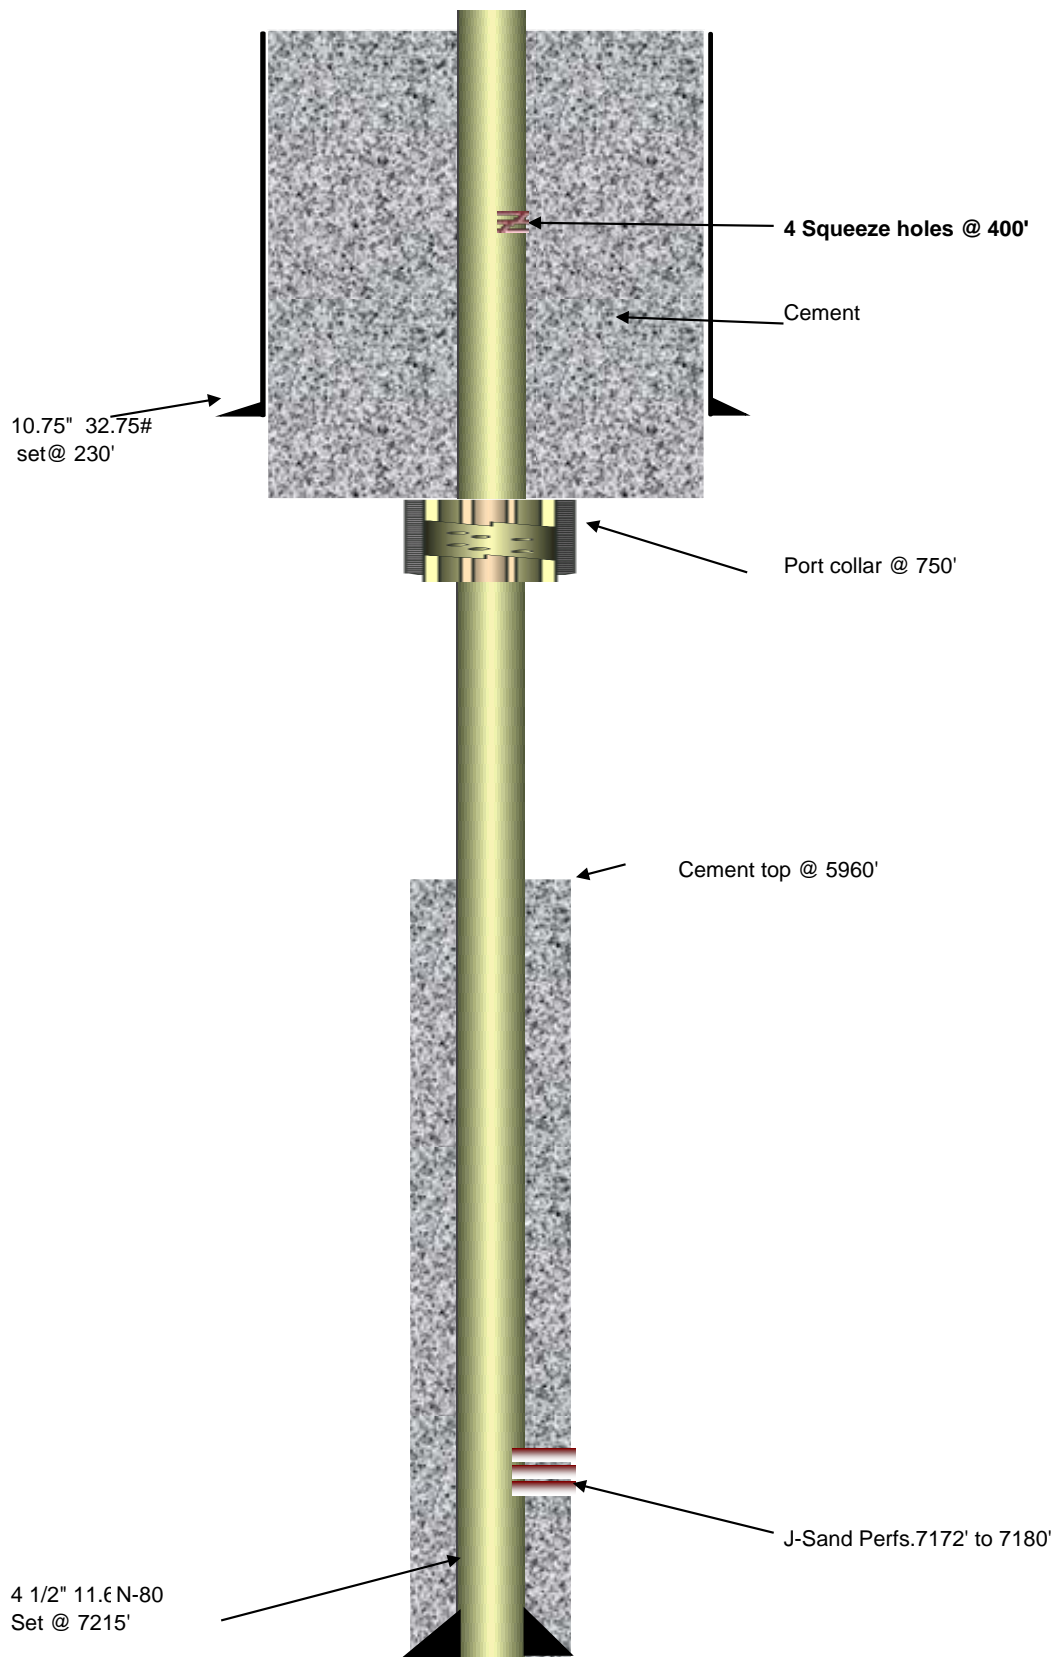

<b>WELL NAME/NUMBER</b> State # 1	<b>DESCRIPTION</b>  <p style="text-align: center;"><b>Current</b></p>		<b>KB</b> THF =  CHF =
<b>FIELD/LEASE/AREA</b> Widlcat	<b>PREPARED</b> Jef Schneider	<b>APPROVED/DATE</b> 11/24/2010	

**Serial Nbr.**  
**API Nbr.** 05-123-05571