


Lease Road

Excavated area

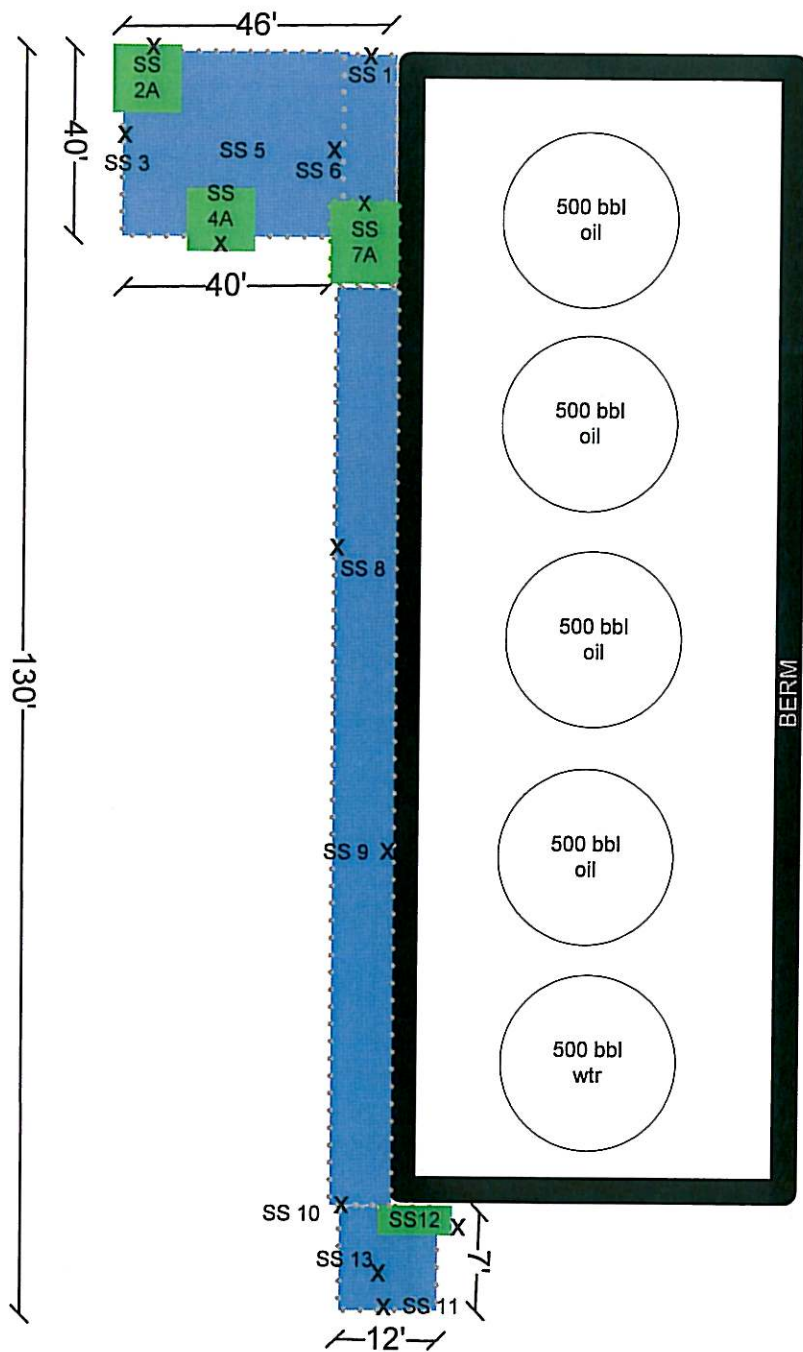

**ne** noble energy

**NOT TO  
SCALE**

**Dillard AB 10-7**