



ACCESS ROAD MAP

KUMMER PC LE23-99HZ

SECTION 23
TOWNSHIP 8 NORTH
RANGE 61 WEST

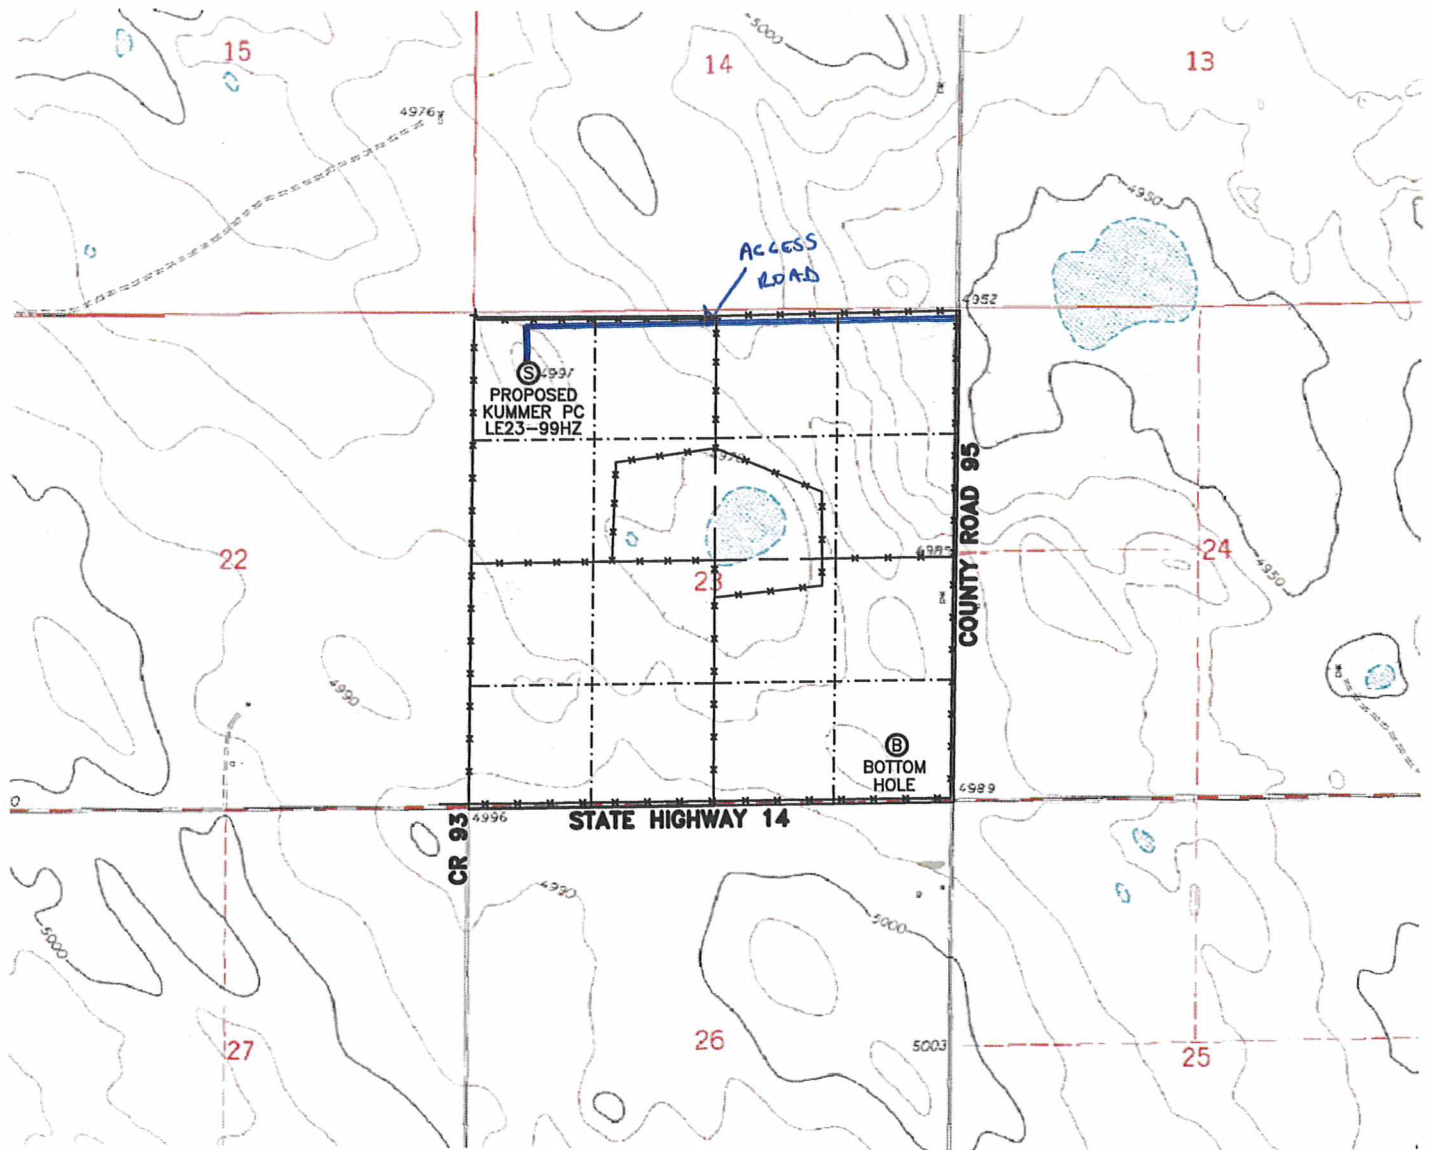

SCALE: 1"=2000'
0 1000 2000

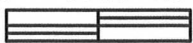

SCALE IN FEET