



Beta 14-10 TR (Timber Ridge Subdivision)

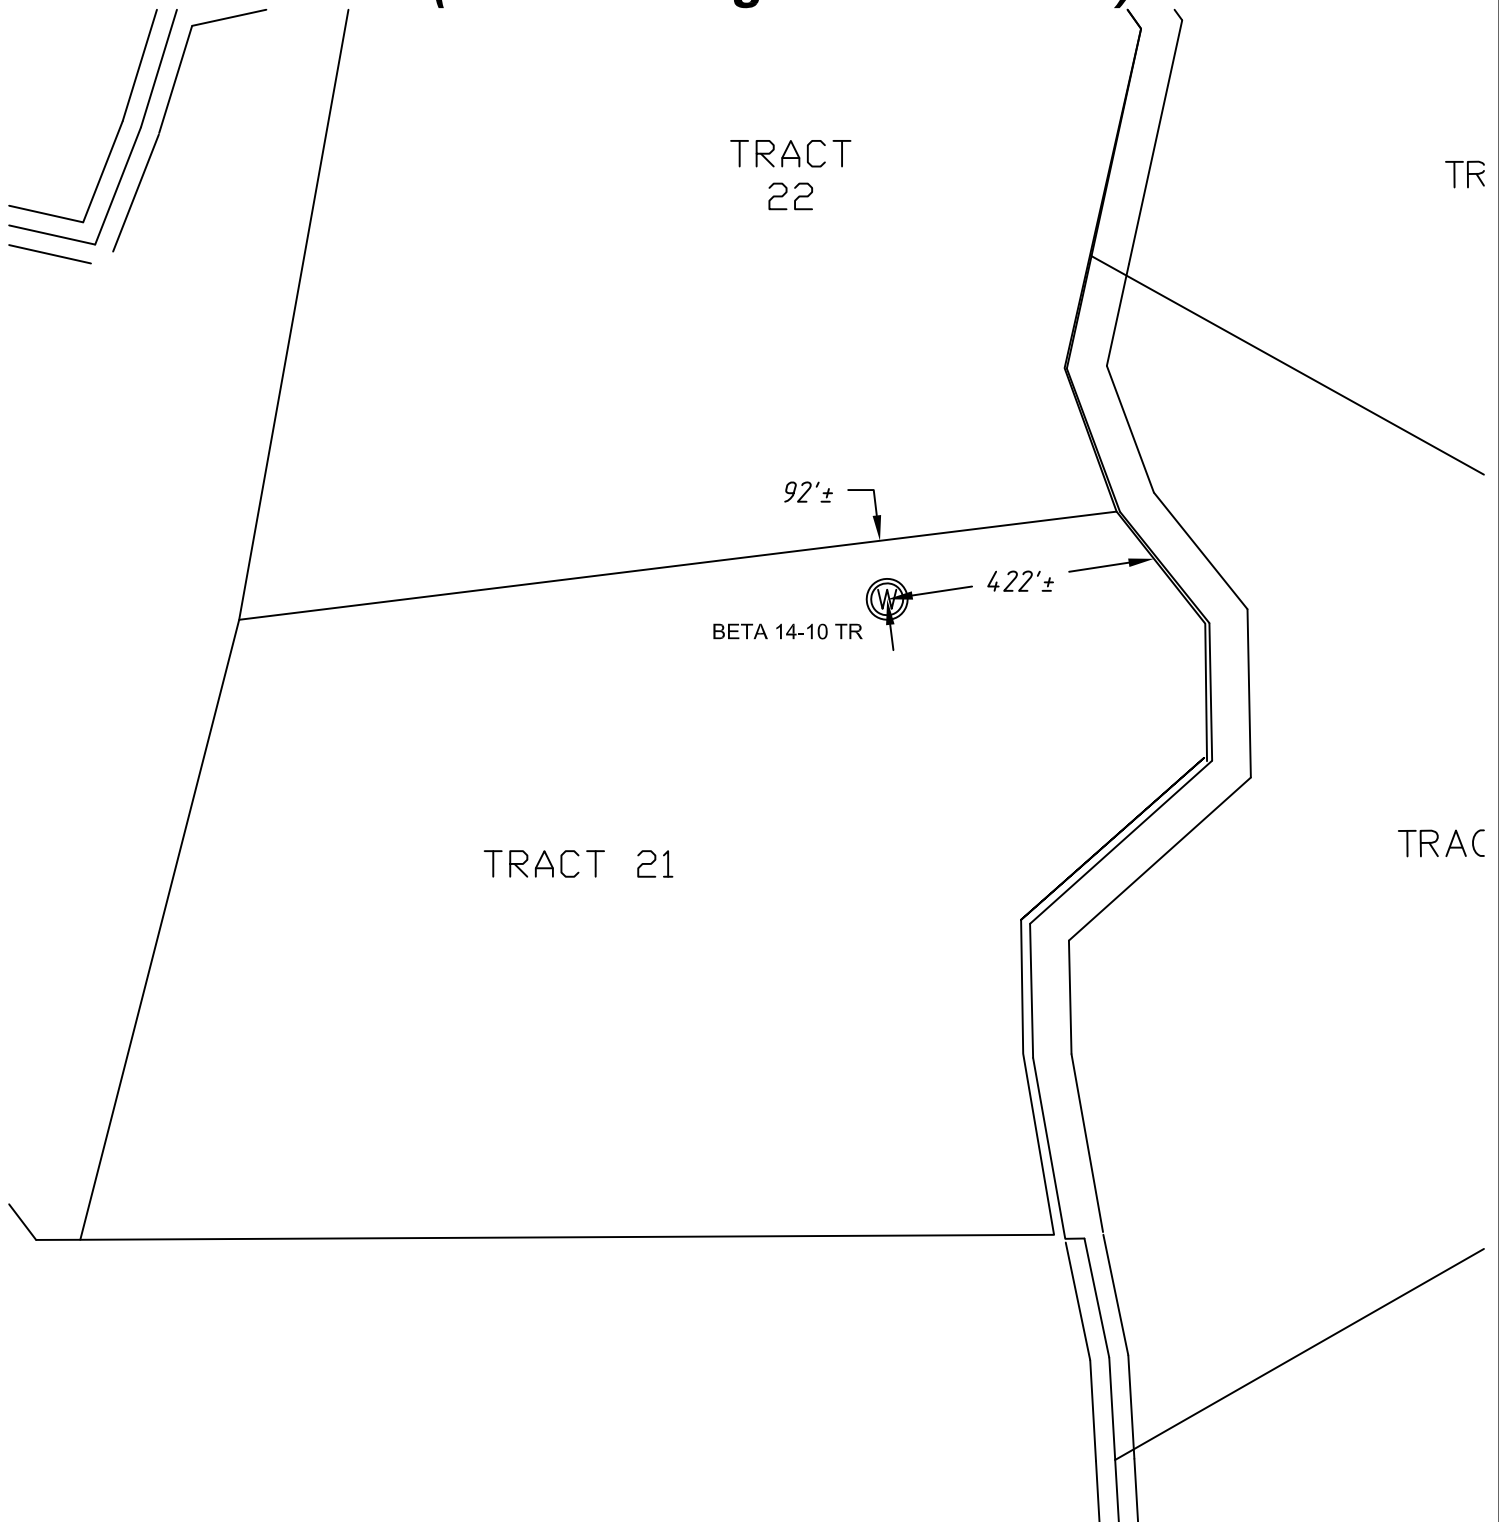

NOTE:
FOOTAGES GIVEN ARE ONLY ESTIMATES BASED ON
SUBDIVISION PLATS AND TIED TO EXISTING CONTROL.
A FULL BOUNDARY SURVEY IS REQUIRED TO DETERMINE
TRUE SUBDIVISION LOT AND ROAD LOCATIONS,
DISTANCES AND AREA OR FOOTAGE CALCULATIONS.

DATE: October 12, 2010

GRAPHIC SCALE

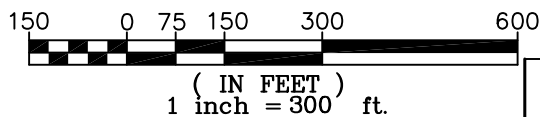

SHIELDS SURVEY L^{td.} C^{o.}
Raton, New Mexico 87740
(575)445-1232