

LOCATION DRAWING STINAR C14-28D

Stell Surveying Services, LLC

1102 West 19th Street P.O. BOX 2073


Cheyenne, Wyoming 82009

VISIBLE IMPROVEMENTS

SECTION 14
TOWNSHIP 4 NORTH
RANGE 64 WEST

DATE: 05/21/2010


THIS MAP DOES NOT REPRESENT A BOUNDARY SURVEY

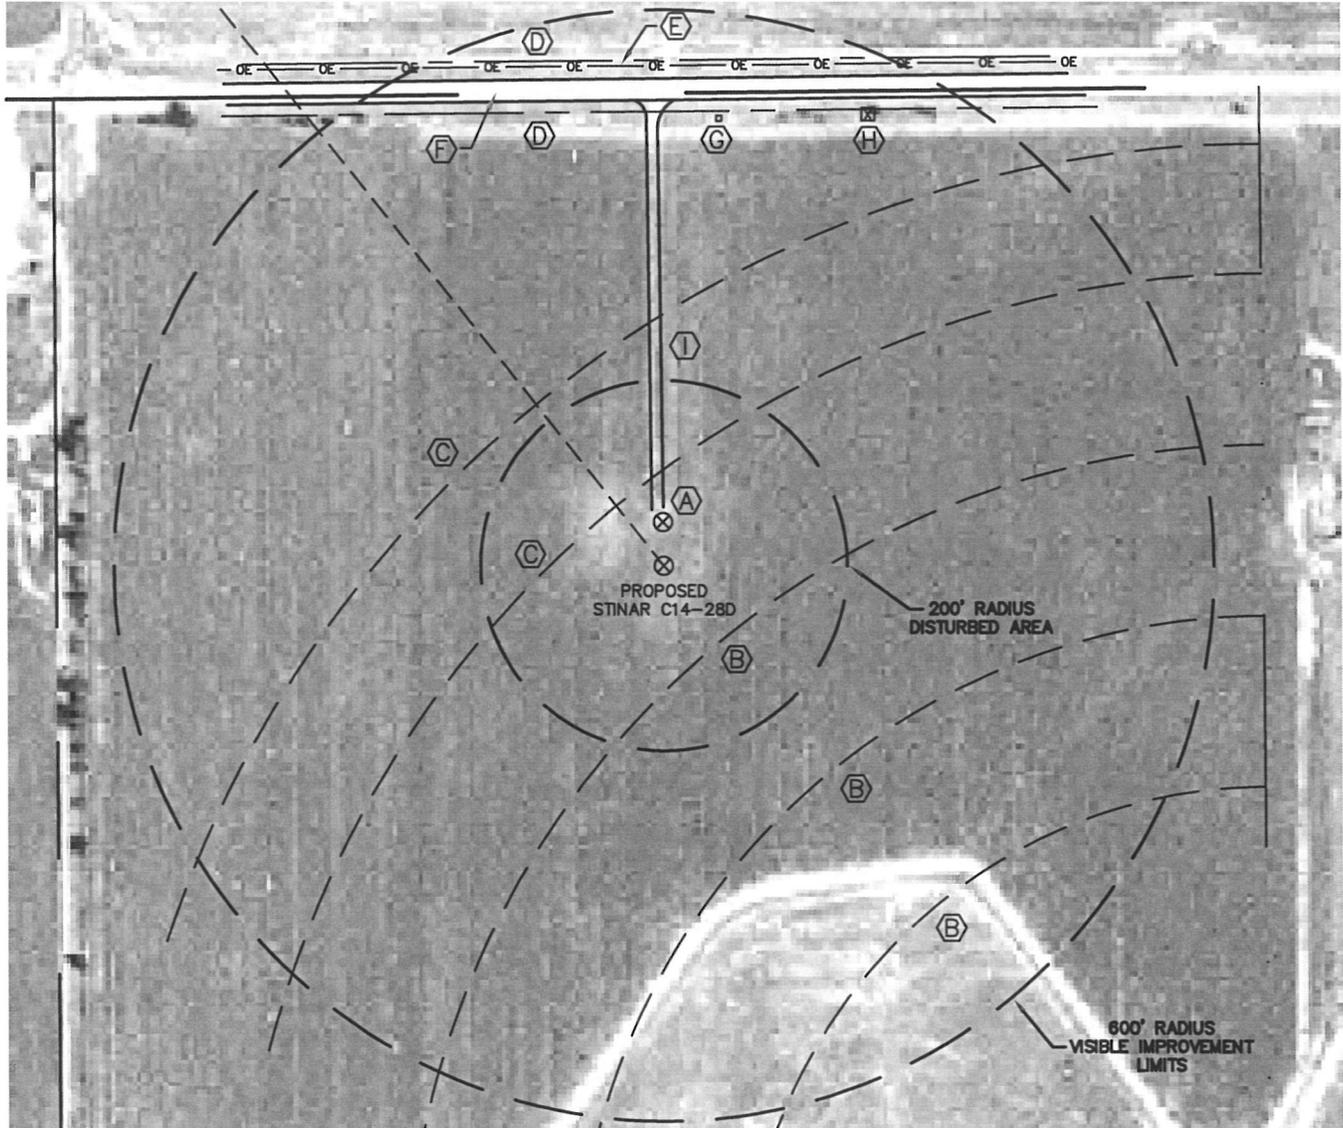

IMPROVEMENTS:

- (A) EXISTING STINAR C14-2(1) - 47' NORTH
- (B) IRRIGATION WHEEL TRACKS - 102', 287' & 471' SOUTHEAST
- (C) IRRIGATION WHEEL TRACKS - 83' & 223' NORTHWEST
- (D) DIRT DITCHES - 490' & 545' NORTH
- (E) OVERHEAD POWER LINE - 539' NORTH
- (F) PAVED COUNTY ROAD NO. 46 - 502' NORTH
- (G) GAS VALVE ENCLOSURE - 436' NORTH
- (H) BURIED CABLE MARKER - 526' NORTHEAST
- (I) DIRT ROAD - 50' NORTH

THE NEAREST OVERHEAD POWER LINE IS 539' NORTH

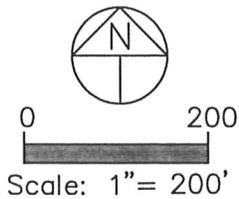

NOTICE: According to Colorado law you MUST commence any legal action based upon any defect in this W.L.C. within three years after you first discover such defect. In no event may any action based upon any defect in this W.L.C. be commenced more than ten years from this sold date of the certification shown hereon.