


Multi Well Plan

SKETCH — STINAR C14-28D

SECTION 14
TOWNSHIP 4 NORTH
RANGE 64 WEST

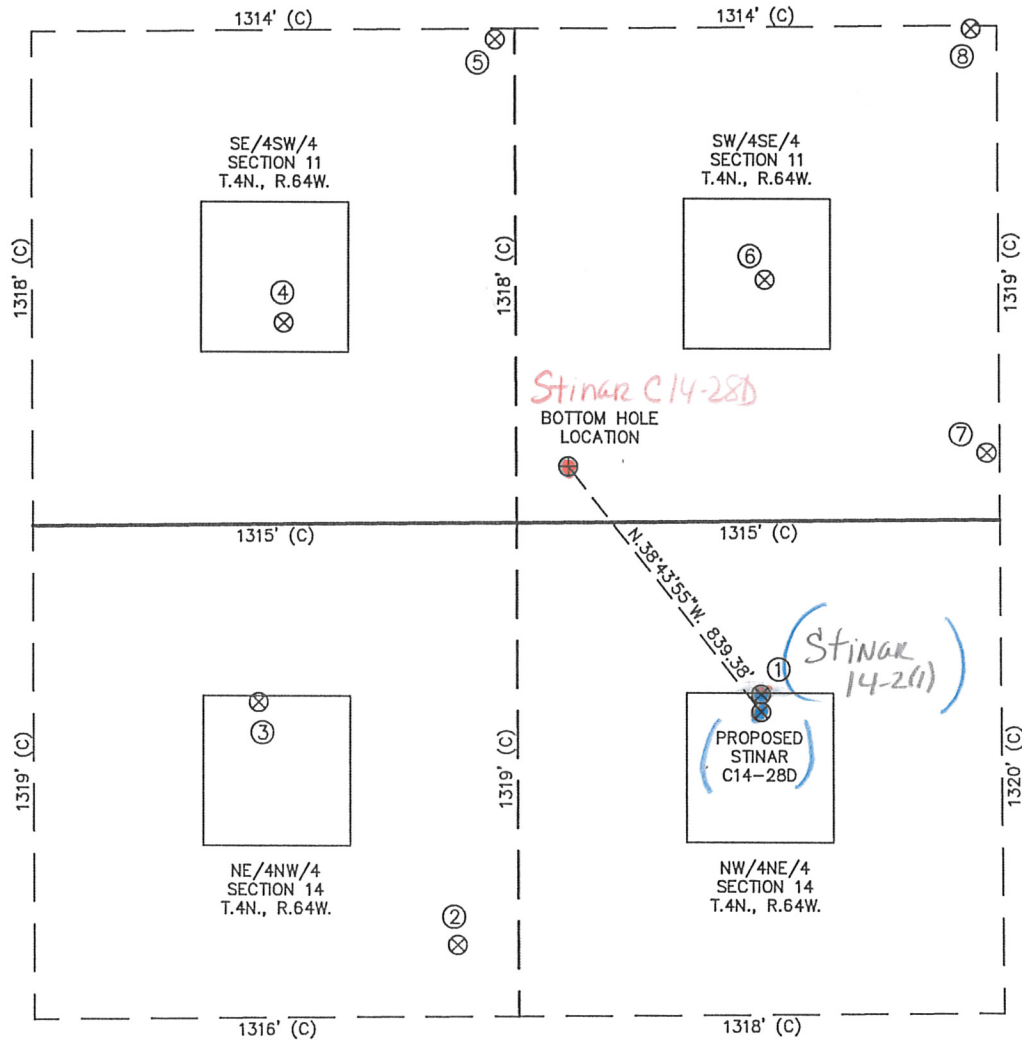

①

STINAR 14-2(1)
NW/NE SEC. 14
463' FNL
1970' FEL
N 40.31842
W 104.51541
PDOP 1.6

②

WILMOTH
C14-18
NE/NW SEC. 14
1128' FNL
2467' FWL
EL 4641'
N 40.31660
W 104.51839
PDOP 2.2

③

WILMOTH 14-3
NE/NW SEC. 14
475' FNL
1927' FWL
EL 4640'
N 40.31839
W 104.52031
PDOP 2.2

④

FOOS C11-14
SE/SW SEC. 11
538' FSL
1998' FWL
EL 4636'
N 40.32117
W 104.52003
PDOP 2.0

⑤

FOOS C11-24
SE/SW SEC. 11
1290' FSL
2576' FWL
EL 4634'
N 40.32323
W 104.51794
PDOP 1.7

⑥

BRETHAUER
11-15
SW/SE SEC. 11
644' FSL
1951' FEL
EL 4634'
N 40.32146
W 104.51533
PDOP 2.6

⑦

BRETHAUER
C14-27
SW/SE SEC. 11
180' FSL
1350' FEL
EL 4634'
N 40.32018
W 104.51318
PDOP 2.6

⑧

BRETHAUER
C11-23
SW/SE SEC. 11
1310' FSL
1384' FEL
EL 4631'
N 40.32329
W 104.51328
PDOP 2.0

NOTES:

- 1) THIS SKETCH DOES NOT REPRESENT A BOUNDARY SURVEY.
- 2) THE DATUM FOR THE LATITUDES AND LONGITUDES ON THIS SKETCH IS NAD83.



0 500

Scale: 1" = 500'