


Wellbore Schematic Input Report

Well Name: WELLS RANCH USX AE19-14

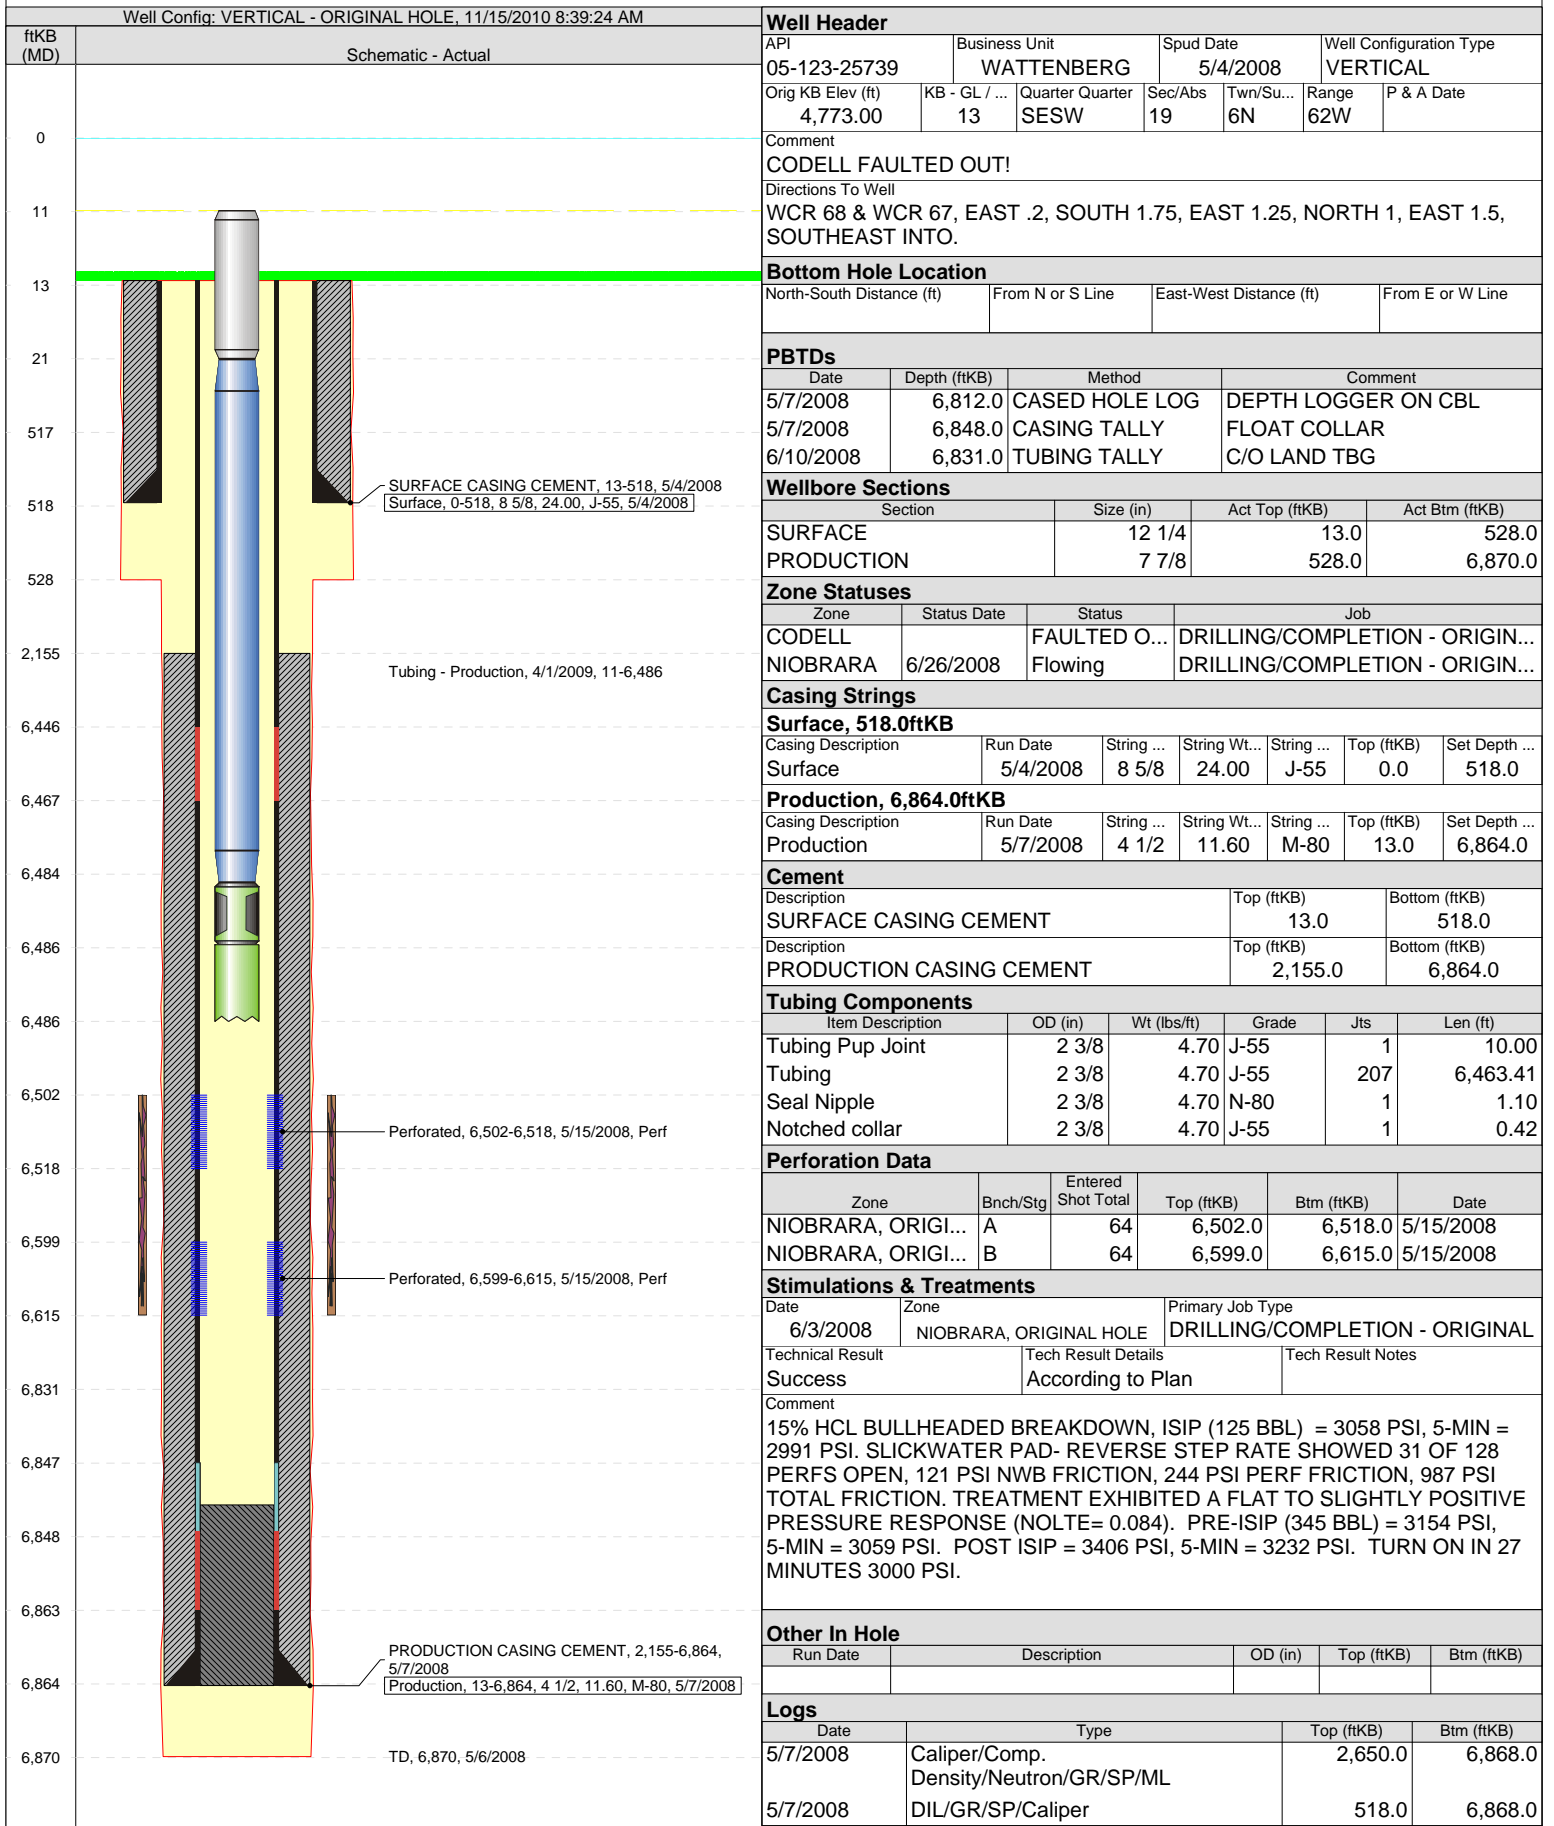

Well Name: WELLS RANCH USX AE19-14

Well Config: VERTICAL - ORIGINAL HOLE, 11/15/2010 8:39:24 AM

Logs

