

Directional Plot


Well : **DAVIS 4-2-9**

Area : Wattenberg

API # : 05123313920000




Top View

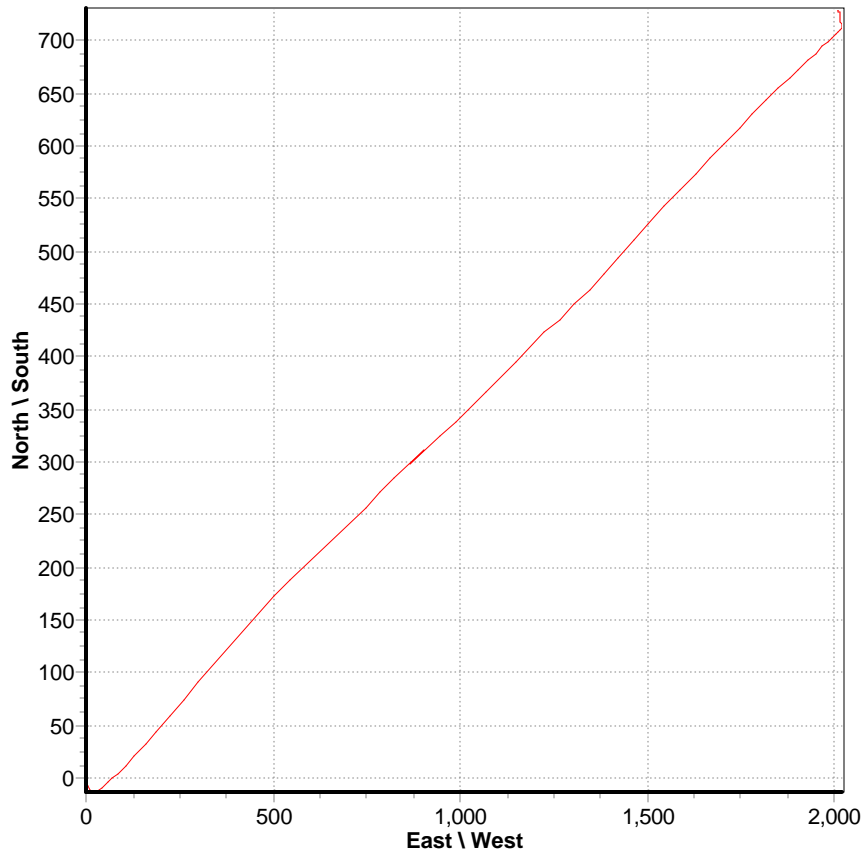

Survey Company : Ensign

TVD	Northings	Eastings
5695.46	710.39	2016.53
5789.40	711.44	2019.28
5884.39	712.29	2020.38
5979.39	712.92	2020.92
6073.39	713.14	2020.91
6168.39	713.52	2020.39
6263.38	714.29	2019.52
6357.36	715.71	2018.65
6452.33	717.91	2017.90
6546.30	720.31	2017.06
6641.27	722.48	2016.05
6735.25	724.34	2015.23
6829.23	725.97	2014.50
6924.22	727.31	2013.67
7018.21	728.19	2012.75
7113.20	728.83	2011.77
7207.19	729.60	2010.92
7301.18	730.33	2010.03
7396.17	731.02	2009.32
7490.17	731.33	2008.84
7585.17	731.15	2008.57
7679.17	730.77	2008.43
7774.17	730.33	2008.20
7891.17	730.32	2007.74
7935.17	730.51	2007.50

East - West Cross Section

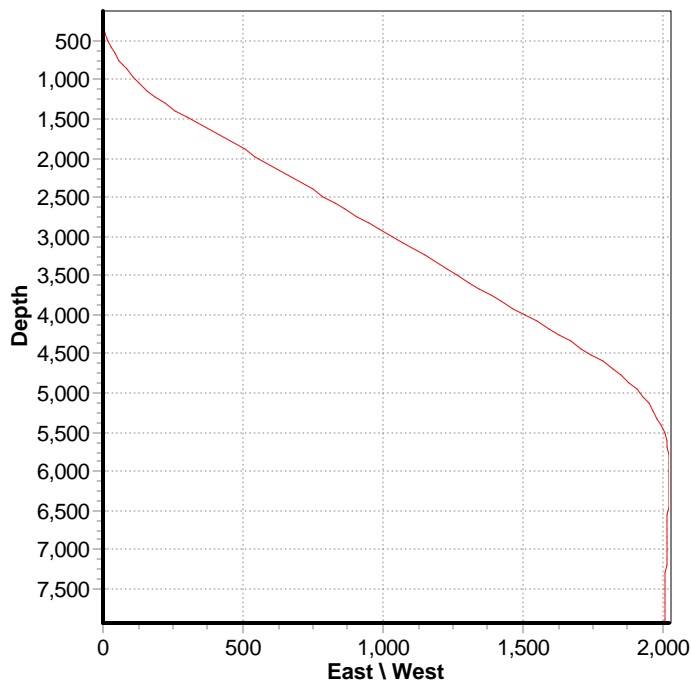

North - South Cross Section

