

# Multi Well Plan


Stell Surveying Services, LLC

1102 West 19th Street P.O. BOX 2073



Cheyenne, Wyoming 82009

## SITE SKETCH

SECTION 16  
TOWNSHIP 3 NORTH  
RANGE 64 WEST

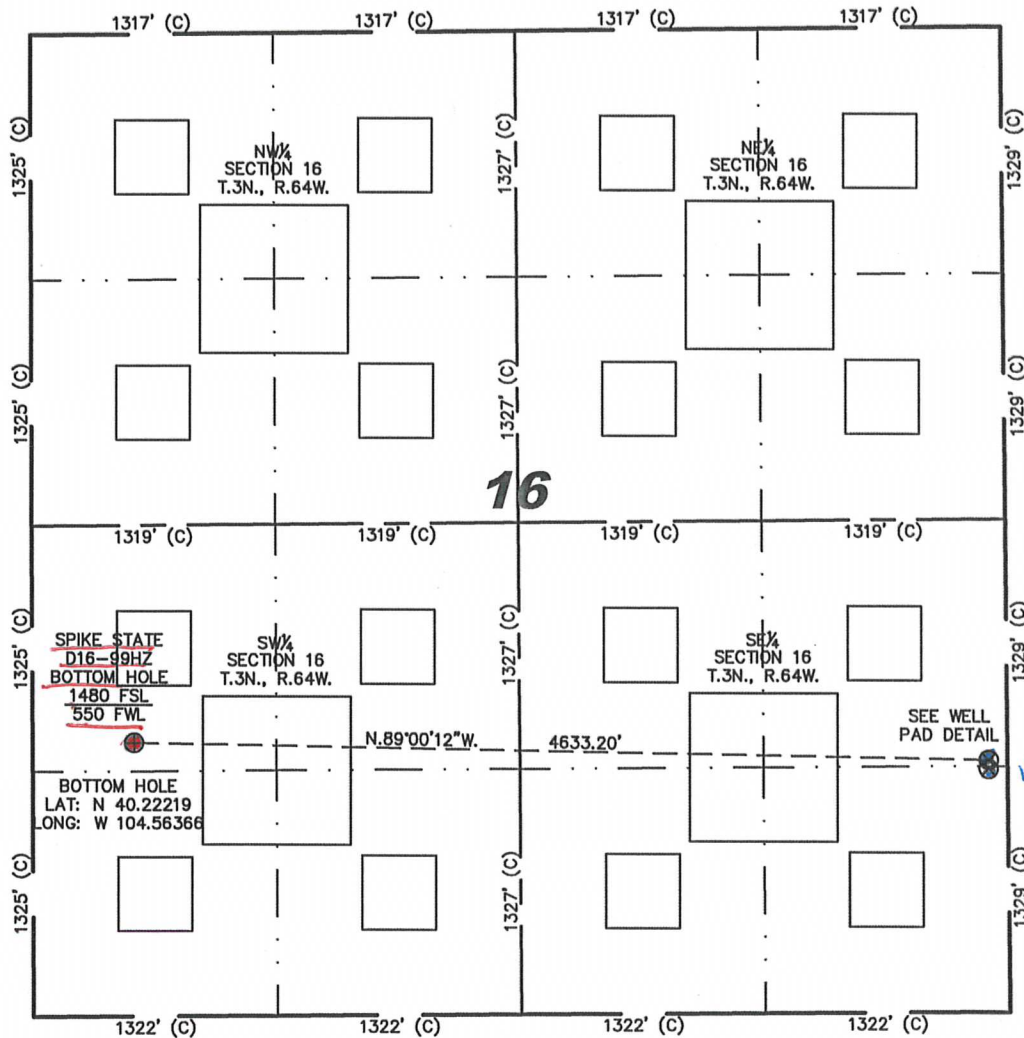

## WELL PAD DETAIL

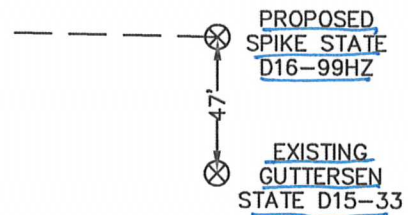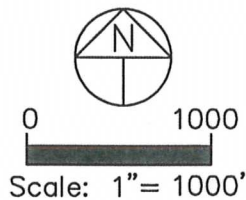

### NOTES:

- 1) THIS SKETCH DOES NOT REPRESENT A BOUNDARY SURVEY.
- 2) THE DATUM FOR THE LATITUDES AND LONGITUDES ON THIS SKETCH IS NAD83.