


# R89W

S89°55'46"W-5263.75'(M)  
S89°59'W-5261.52'(R)

**NAD83**  
BATTLE MOUNTAIN  
FEDERAL 14-10L  
LAT 40°59'32.3"  
(40.992306)  
LONG 107°20'23.5"  
(107.339853)  
  
STATE PLANE (CO-N)  
N=1,609,623 ft  
E=2,492,096 ft

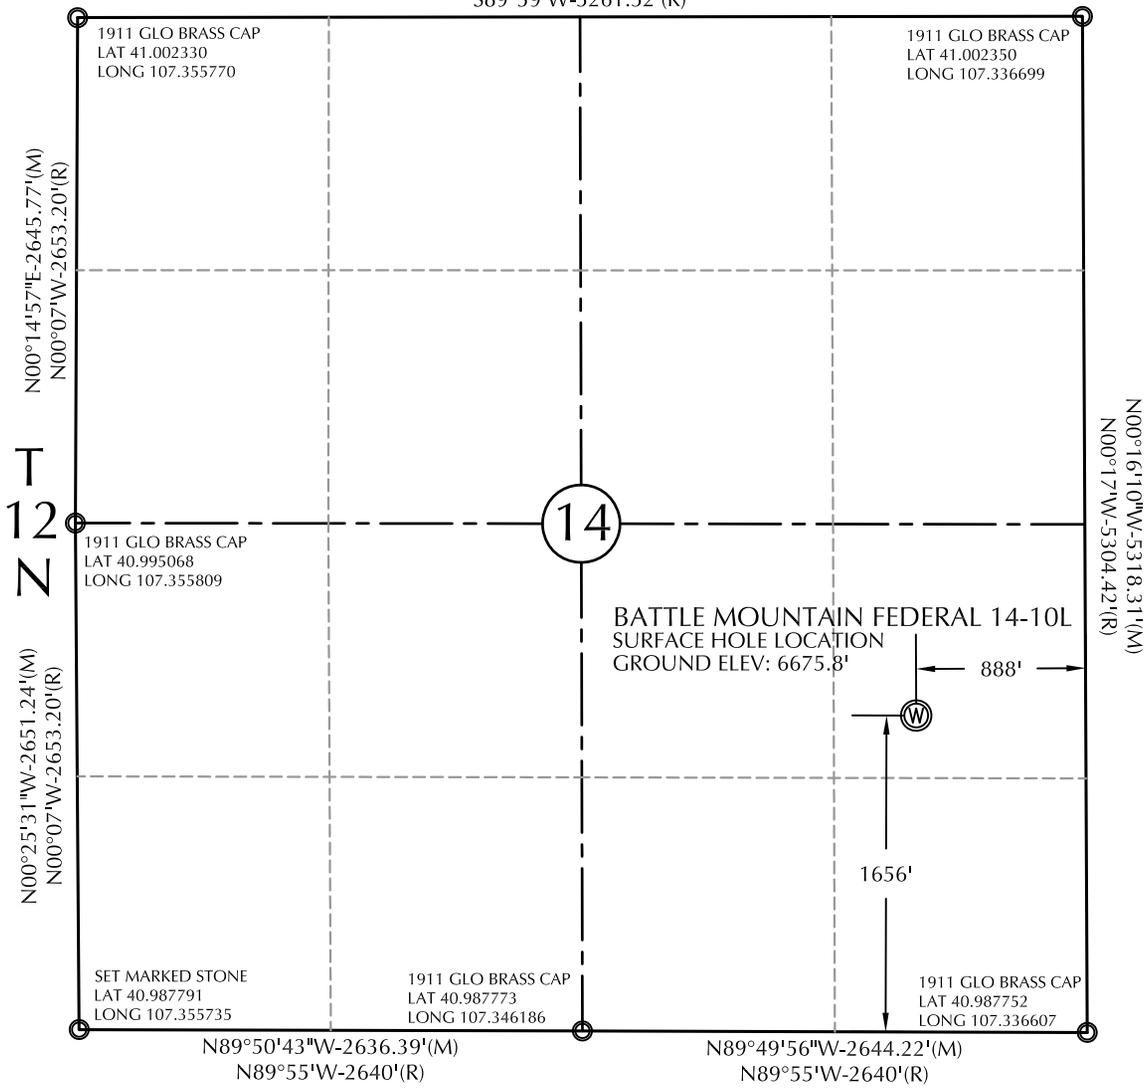

**NOTES:**


1. INDICATES FOUND MONUMENT AS DESCRIBED
2. ELEVATIONS BASED ON NGVD29 BENCH MARK (X72) EL: 6555.98'
3. THE BASIS OF BEARING IS NAD83 DERIVED FROM POST-PROCESSED STATIC GPS OBSERVATIONS.
4. PDOP VALUE EQUALS 2.7
5. GPS OPERATOR: DAVE SIMS

**REFERENCE STAKES:**

- 175' WEST - 6682.1'
- 200' WEST - 6683.1'
- 200' SOUTH - 6712.8'
- 225' SOUTH - 6718.2'

**CERTIFICATE OF SURVEYOR**

I, David A. Fehringer of Lander, Wyoming hereby certify that this map was made from notes taken during an actual survey made on June 4, 2010, and that it correctly shows the drilling location of ENTEK GRB, LLC., Battle Mountain Federal 14-10L as located during said survey.

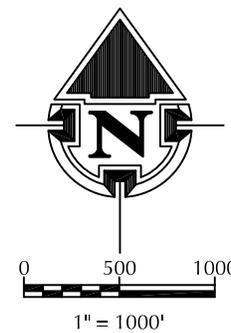

## ENTEK GRB, LLC

BATTLE MOUNTAIN FEDERAL 14-10L  
WELL LOCATION CERTIFICATE  
1656' FSL, 888' FEL  
NE 1/4 SE 1/4, SECTION 14,  
T.12N., R.89W., 6th PM  
MOFFAT COUNTY, COLORADO

**CHOICE ENGINEERING SERVICES**  
404 "N" Street - Suite 201 | Rock Springs, WY 82901  
Phone 307-362-6065 | Fax 307-362-6064

Scale: 1"=1000'	Date: 06/22/10	SHEET NO:
REVISED:	BY DATE	1