


DALEY LAND SURVEYING, INC.

PARKER, CO. 80134

303 953 9841

# VISIBLE IMPROVEMENTS SKETCH BERNHARDT PC J31-30D

SECTION 31, TOWNSHIP 5 NORTH, RANGE 66 WEST OF THE 6TH PRINCIPAL MERIDIAN

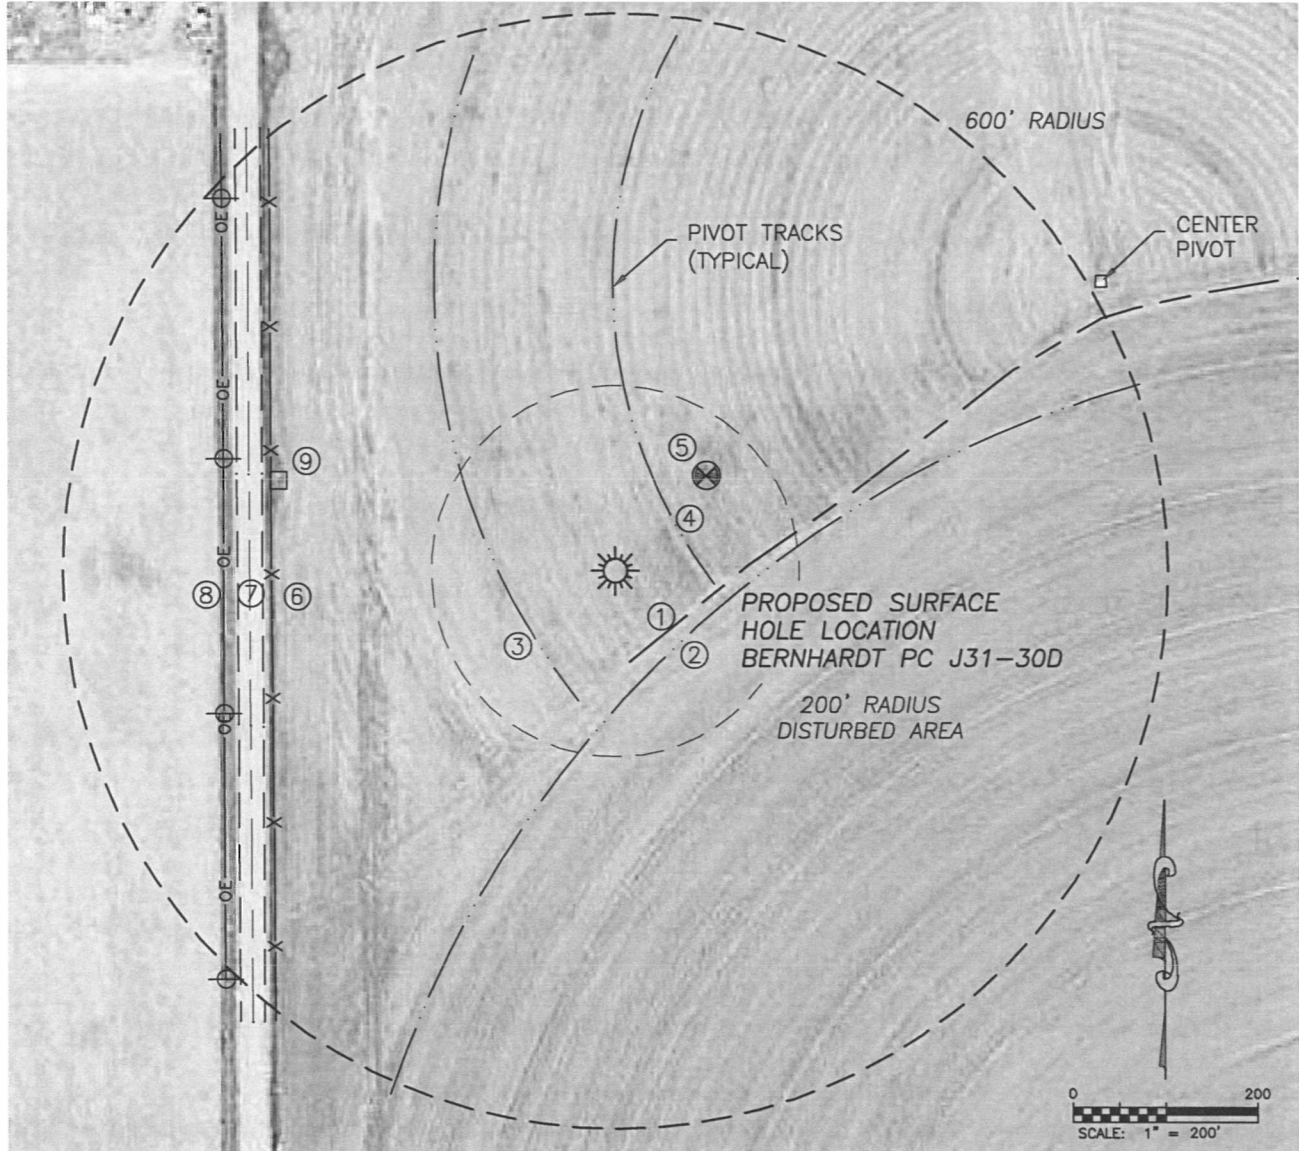

①  
CENTERLINE  
FIELD ROAD  
85'± SE

②  
PIVOT TRACK  
105'± SE

③  
PIVOT TRACK  
110'± SW

④  
PIVOT TRACK  
85'± NE

⑤  
WELL:  
UPRC 31-4H6  
143'± NE

⑥  
WIRE FENCE  
375'± W

⑦  
EAST EDGE  
WCR 25  
385'± W

⑧  
OVERHEAD  
POWER  
425'± W

⑨  
CONCRETE  
IRRIG. BOX  
370'± NW

NEAREST OVERHEAD POWER 425'± W