



**Marathon
Oil Company**

Updated: 12/10/2010

Well Name: Chevron Marathon 14D-14D
 SAP CC :
 Lat/Long:
 Location: NW NW S23; T6S; R97W; 213' FNL & 446' FWL
 County: Garfield County, Colorado
 Field : Grand Valley
 API #: 05-045-14440-00
 Lease: 854500
 Permit: 20073854

WI: 100
 NRI:

Spud Date: 12/4/2007
 Completion:
 1st Flow :

GL: 8,498'
 KB: 8,516'


ID: 20" 84# set @ 100'

ID: 9 5/8" 36# J-55 set @ 2661'
 Cemented with class 'G' 1309 sx lead, 350 sx
 tail 11.6/14.2 ppg. Float Held.
 Topped out with 136 sxs

ID: 4 1/2" 11.6# M-80 set @ 9145'
 Cemented with 800 sx BJS High Strength Lite
 Bumped plug with 1800 psi, float held

TOC w/ 60% bond @ 4864'
 CBL: Baker Atlas
 26-Jan-08

NO.	Tubing DESCRIPTION	LENGTH
1	Tubing Hanger	0.51
275	2-3/8" L-80 4.7#	8808.62
1	2-3/8" L-80 4.7# pup jt	2.09
1	2-3/8" L-80 4.7#	32.63
1	1.875" Profile Nipple	1.14
1	2-3/8" L-80 4.7#	4.40
1	Shear coupling	0.69
		KB 18.00
		Depth 8868.08

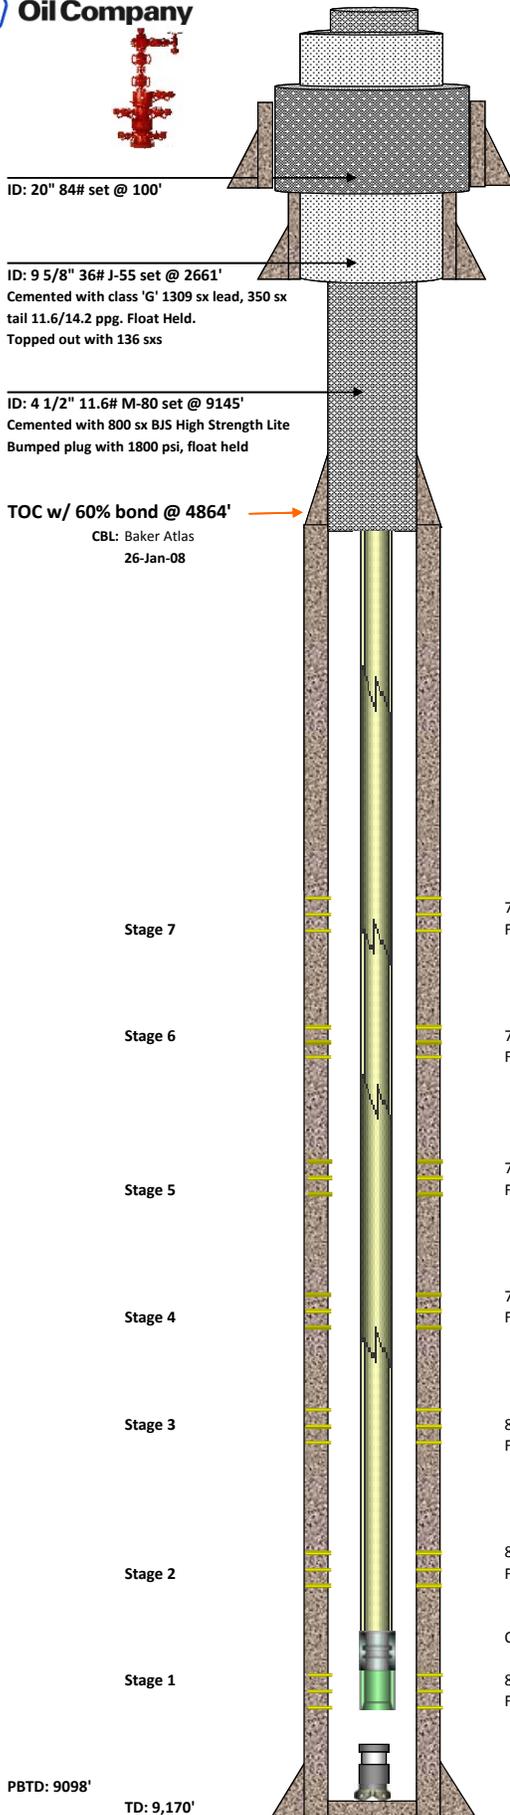

Stage 7

7093'-7094', 7103'-7105', 7118'-7120', 7174'-7176', and 7215'-7217' all 3 spf
 Frac'd with 110,525# 30/50 white and 2715 bbls

Stage 6

7316'-7318', 7386'-7387', 7395'-7397', 7472'-7473', 7490'-7492', and 7524'-7526' all 3 spf
 Frac'd with 95,256# 30/50 white and 3250 bbls

Stage 5

7604'-7605', 7611'-7612', 7620'-7621', 7646'-7647', 7720'-7722', and 7750'-7753' all 3 spf
 Frac'd with 158,192# 30/50 white and 4232 bbls

Stage 4

7903'-7906', 7930'-7933', and 7970'-7973' all 3 spf
 Frac'd with 103,359# 30/50 white and 2923 bbls

Stage 3

8030'-8033', 8062'-8064', 8146'-8150', and 8160'-8163' all 2 spf
 Frac'd with 89,425# 30/50 white and 2588 bbls

Stage 2

8343'-8345', 8488'-8496', and 8564'-8566' all 2 spf
 Frac'd with 68,728# 30/50 white and 2152 bbls

Stage 1

CBP set @ 8600'
 8774'-8778', 8846'-8847', 8857'-8859', and 8904'-8905' all @ 3 spf
 Frac'd with 61,909# 30/50 white and 2594 bbls

PBD: 9098'

TD: 9,170'