




**Marathon
Oil Company**

Updated: 12/10/2010

Well Name: Chevron Marathon 41A-22D
 SAP CC :
 Lat/Long:
 Location: NW NW S23; T6S; R97W; 208' FNL & 432' FWL
 County: Garfield County, Colorado
 Field : Grand Valley
 API #: 05-045-14441-00 WI:
 Lease: 854500 NRI:
 Permit: 20073853

Spud Date: 12/23/2007 GL: 8,498'
 Completion: KB: 8,516'
 1st Flow :

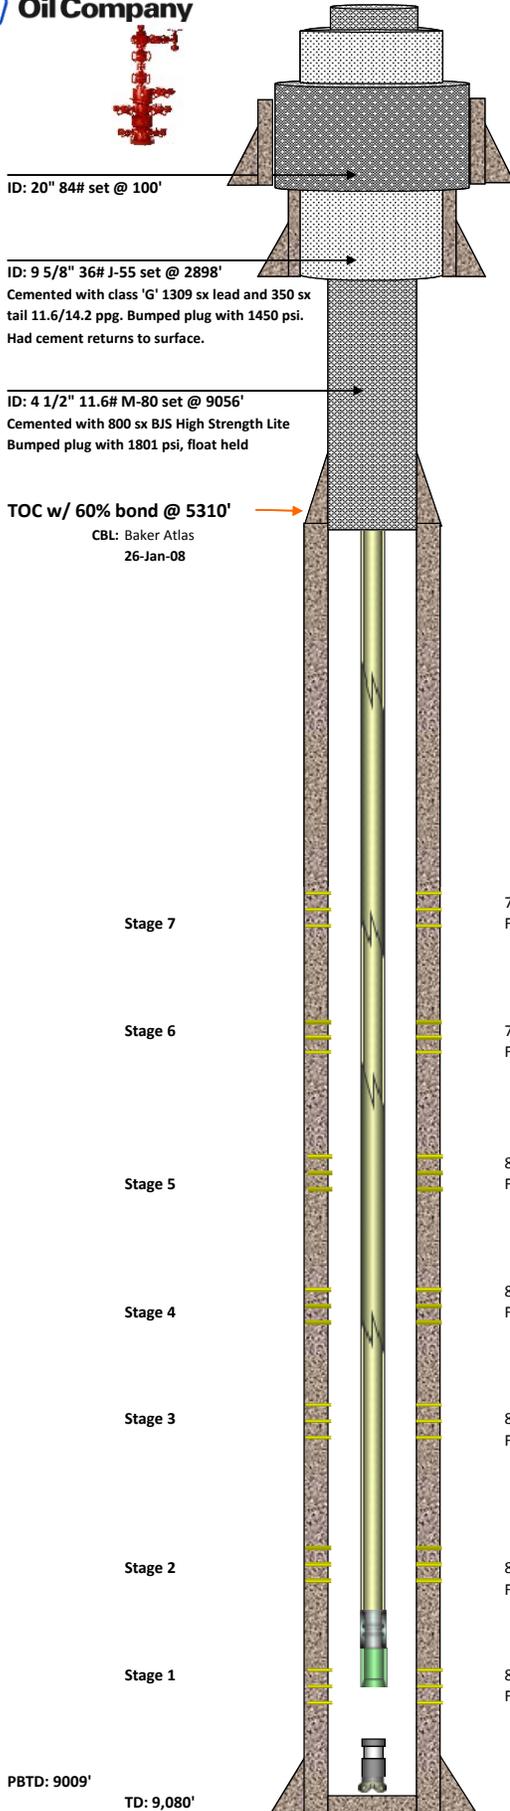

NO.	DESCRIPTION	LENGTH
1	Tubing Hanger	0.83
272	2-3/8" L-80 4.7#	8726.32
1	2-3/8" L-80 4.7# pup jt	2.08
1	2-3/8" L-80 4.7#	32.58
1	1.875" Profile Nipple	1.14
1	2-3/8" L-80 4.7#	4.42
1	Pumped off bit sub	0.64
	KB	18
	Depth	8786.01

Stage 7 7164'-7165', 7173'-7175', 7196'-7198', 7274'-7276', and 7334'-7335' all 3 spf
 Frac'd with 101,303# 30/50 white and 3067 bbls

Stage 6 7536'-7538', 7554'-7556', 7622'-7625', and 7658'-7660' all 3 spf
 Frac'd with 94,018# 30/50 white and 2764 bbls

Stage 5 8016'-8018', 8024'-8026', 8062'-8064', and 8070'-8072' all 3 spf
 Frac'd with 51,318# 30/50 white and 1616 bbls

Stage 4 8221'-8224', 8245'-8248', and 8277'-8280' all 3 spf
 Frac'd with 65,702# 30/50 white and 2094 bbls

Stage 3 8369'-8371', 8379'-8381', 8420'-8422', 8442'-8443', and 8452'-8454' all 3 spf
 Frac'd with 103,364# 30/50 white and 2919 bbls

Stage 2 8646'-8658' 2 spf
 Frac'd with 38,000# 30/50 white and 1572 bbls

Stage 1 8744'-8748', 8756'-8758', 8768'-8770', and 8821'-8825' all @ 2 spf
 Frac'd with 58,624# 30/50 white and 1960 bbls

PBDT: 9009'

TD: 9,080'