




**Lease Name:** Meyer #3

**Legals:** NWNW – Sec. 21, T5N, R66W

**County:** Weld County, Colorado

**API#:** 05-123-29171

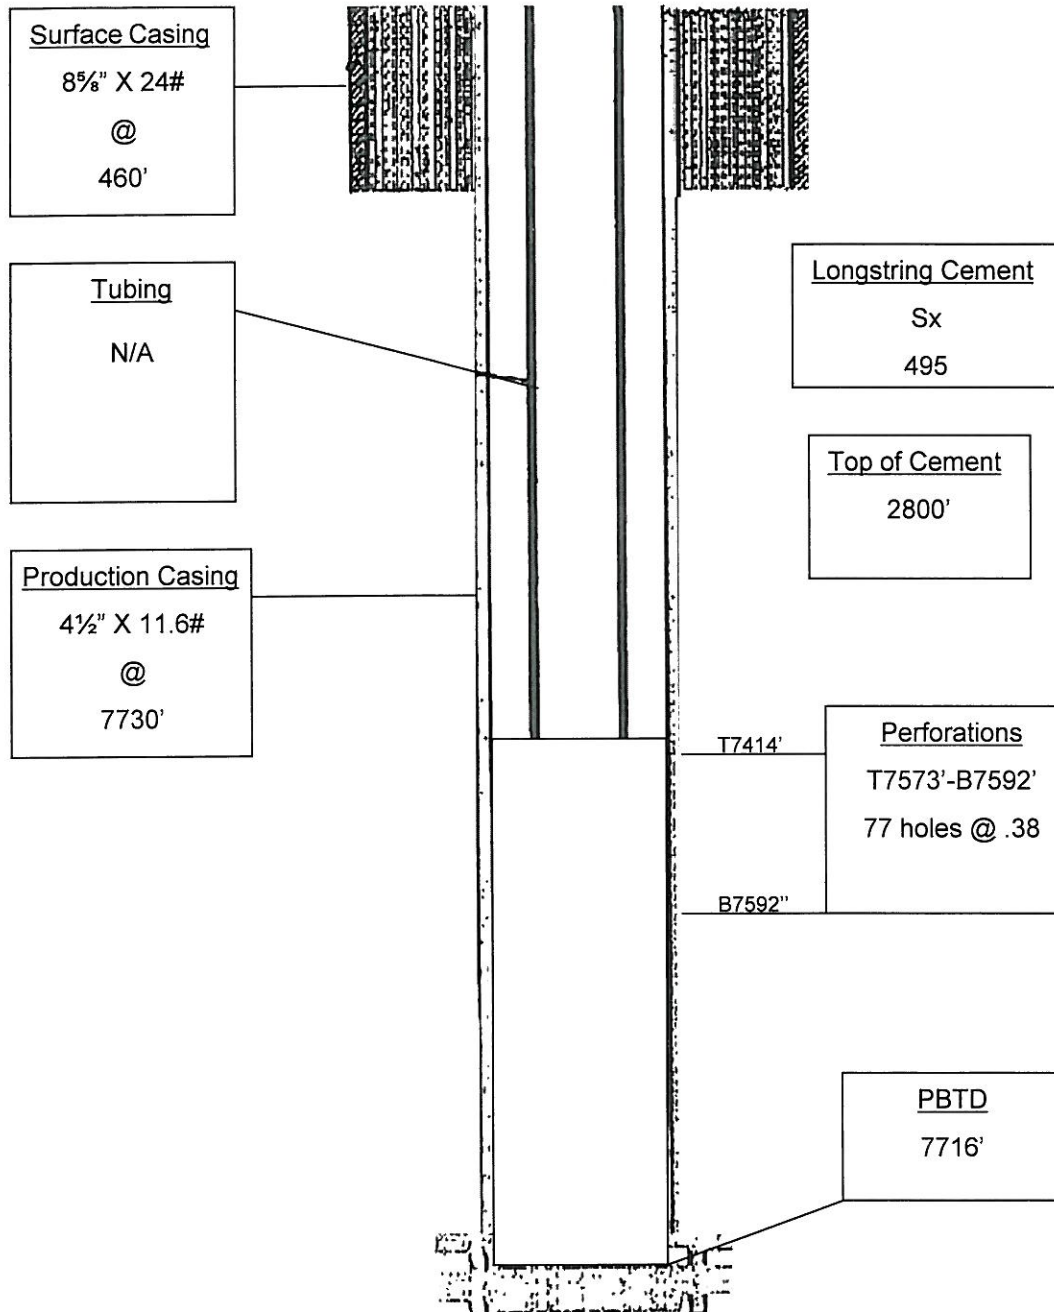

**Wellbore Diagram**