

Well Completion Diagram

API Well No: 05-123-14611-00-


Owner: ENCANA OIL & GAS (USA) INC Well Name: KUGEL

County: WELD Field: WATTENBERG Pool:

Coordinates: X 1320 FWL ; Y 1320 FNL Sec: 18 Twp: 2N Rng: 67W

Note: Changes to the drawing do not effect the database

Bore Diameters (in.)

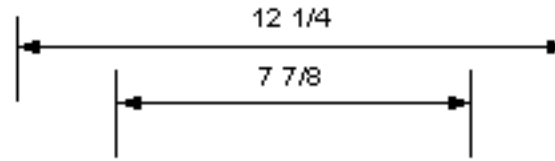

Cement Top: 0' mthd:U

Cement Top: 0' mthd:U

8 5/8" SURF 349'

4 1/2" 1ST 8,020'

Total Vertical Depth 8,003'

Perfs. 7,904-7,950'

