

Well Completion Diagram

API Well No: 05-123-21024-00-


Owner: ENCANA ENERGY RESOURCES INC. Well Name: CONNER

County: WELD Field: WATTENBERG Pool:

Coordinates: X 560 FEL ; Y 2080 FNL Sec: 4 Twp: 1N Rng: 66W

Note: Changes to the drawing do not effect the database

Bore Diameters (in.)

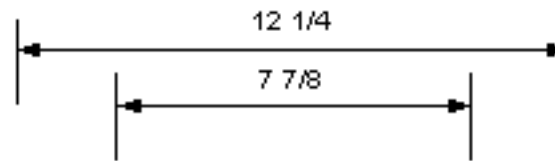

Cement Top: 0' mthd:U

8 5/8" SURF 991'

Cement Top: 4,487' mthd:U

2 3/8" Tubing 7,928'

Total Vertical Depth 8,096'

4 1/2" 1ST 8,099'

