

# Well Completion Diagram

API Well No: 05-123-21015-00-


Owner: ENCANA ENERGY RESOURCES INC. Well Name: TWOMBLY

County: WELD Field: WATTENBERG Pool:

Coordinates: X 2122 FEL ; Y 712 FNL Sec: 4 Twp: 1N Rng: 66W

Note: Changes to the drawing do not effect the database

Bore Diameters (in.)

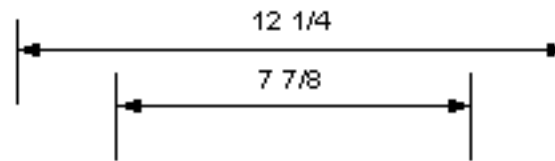

Cement Top: 0' mthd:U

8 5/8" SURF 970'

Cement Top: 3,900' mthd:U

Cement Top: 6,822' mthd:U

2 3/8" Tubing 8,138'

Total Vertical Depth 8,138'

4 1/2" 1ST 8,150'

