


SURVEYOR'S STATEMENT

I, DAVID E. HENDERHAN, AN EMPLOYEE AND AGENT ON BEHALF OF D.R. GRIFFIN & ASSOCIATES, INC. STATE THE PLAT HEREON IS A CORRECT REPRESENTATION OF A SURVEY MADE UNDER MY SUPERVISION ON DECEMBER 16, 2010 OF THE SHOWN CASCADE CREEK 697-05-42 AND THAT THE LOCATION HAS BEEN STAKED ON THE GROUND AS SHOWN ON THE PLAT.

Notice: In accordance with Colorado State Law, any legal action based upon any defect in this survey plat must commence within three (3) years after first discovery of such defect. In no event, may any action based upon any defect in this survey plat be commenced more than ten (10) years from the date of certification shown hereon.

CC 697-05C PAD

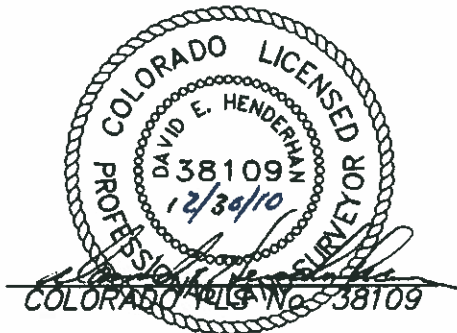

GRIFFIN & ASSOCIATES, INC.

(307) 362-5028

1414 ELK ST., ROCK SPRINGS, WY 82901

DRAWN: 12/30/10 - DEH

SCALE: 1" = 1000'

REVISED: N/A

DRG JOB No. 18285

EXHIBIT 1

PLAT OF DRILLING LOCATION IN
LOT 14, SECTION 5, FOR
OXY USA WTP LP

3037' F/NL & 2334' F/EL, SECTION 5,
T. 6 S., R. 97 W., 6th P.M.,
GARFIELD COUNTY, COLORADO