


# WELL LOCATION CERTIFICATE


THIS MAP DOES NOT REPRESENT A BOUNDARY SURVEY

SECTION: 20  
TOWNSHIP: 2N  
RANGE: 64W

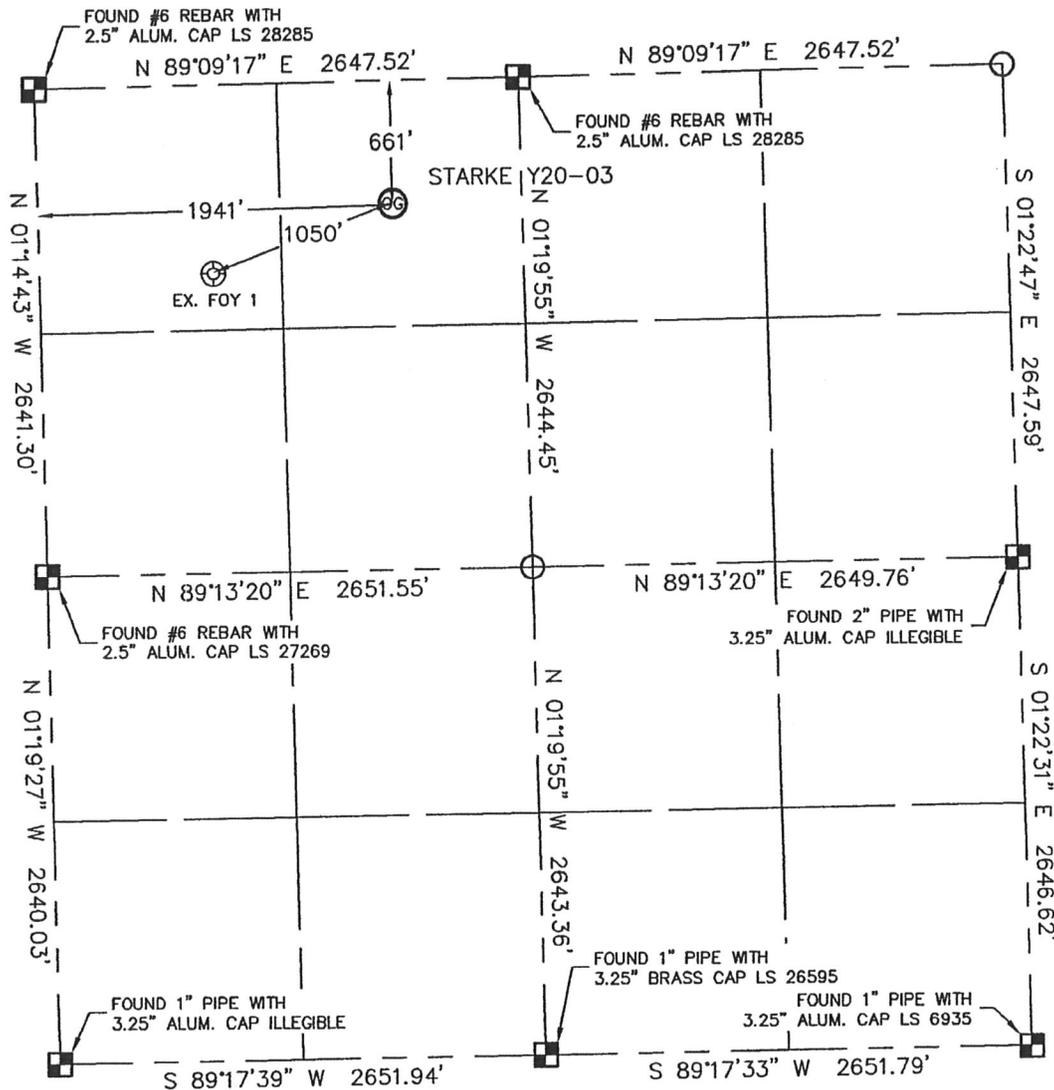

In accordance with a request from CJ PIETRI with Noble Energy Inc. Lat40°, LLC has determined the surface location of the STARKE Y20-03 to be 661' from the NORTH line and 1941' from the WEST line as measured at right angles from the section lines of Section 20, Township 2 North, Range 64 West of the Sixth Principal Meridian, County of Weld, State of Colorado.

I hereby state that this Well Location Certificate was prepared by me, or under my direct supervision, that the fieldwork was completed on 12/16/10, for and on behalf of Noble Energy Inc. That this is not a Land Survey Plat or an Improvement Survey Plat, and that it is not to be relied upon for establishment of fence, building, or other future improvement lines.

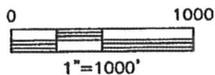

**NOTE:**

- 1) Bearings shown are Grid Bearings of the Colorado State Plane Coordinate System, North Zone, North American Datum 1983/2007. The lined dimensions as contained herein are based upon the "U.S. Survey Foot."
- 2) Ground elevations are based on an observed GPS elevation (NAVD 1988 DATUM).
- 3) NEAREST EXISTING WELL: FOY 1, 1050'
- 4) IMPROVEMENTS: See LOCATION DRAWING for all visible improvements within 400' of disturbed area.
- 5) SURFACE USE: DRYLAND CROP
- 6) INSTRUMENT OPERATOR: AARON LUND

**SURFACE LOCATION**

LATITUDE: 40.12940N  
LONGITUDE: 104.57777W  
PDOP: 1.2  
ELEV: 4904'  
1/4,1/4: NE1/4NW1/4  
NEAREST PROPERTY LINE: 661' NORTH



**NOTE**

According to Colorado law, you must commence any legal action based upon any defect in this W.L.C. within three years after you discover such defect. In no event, may any action based upon any defect in this survey be commenced more than ten years after the date of the certificate shown hereon. (13-80-105 C.R.S.)

### LEGEND

- = ALIQUOT MONUMENT AS DESCRIBED
- = CALCULATED POSITION


Brian T. Brinkman—On behalf of Lat40°, LLC  
Colorado Licensed Professional  
Land Surveyor No. 38175

PROJECT#: 2010159

# SITE SKETCH

STARKE Y20-03

SECTION: 20  
TOWNSHIP: 2N  
RANGE: 64W

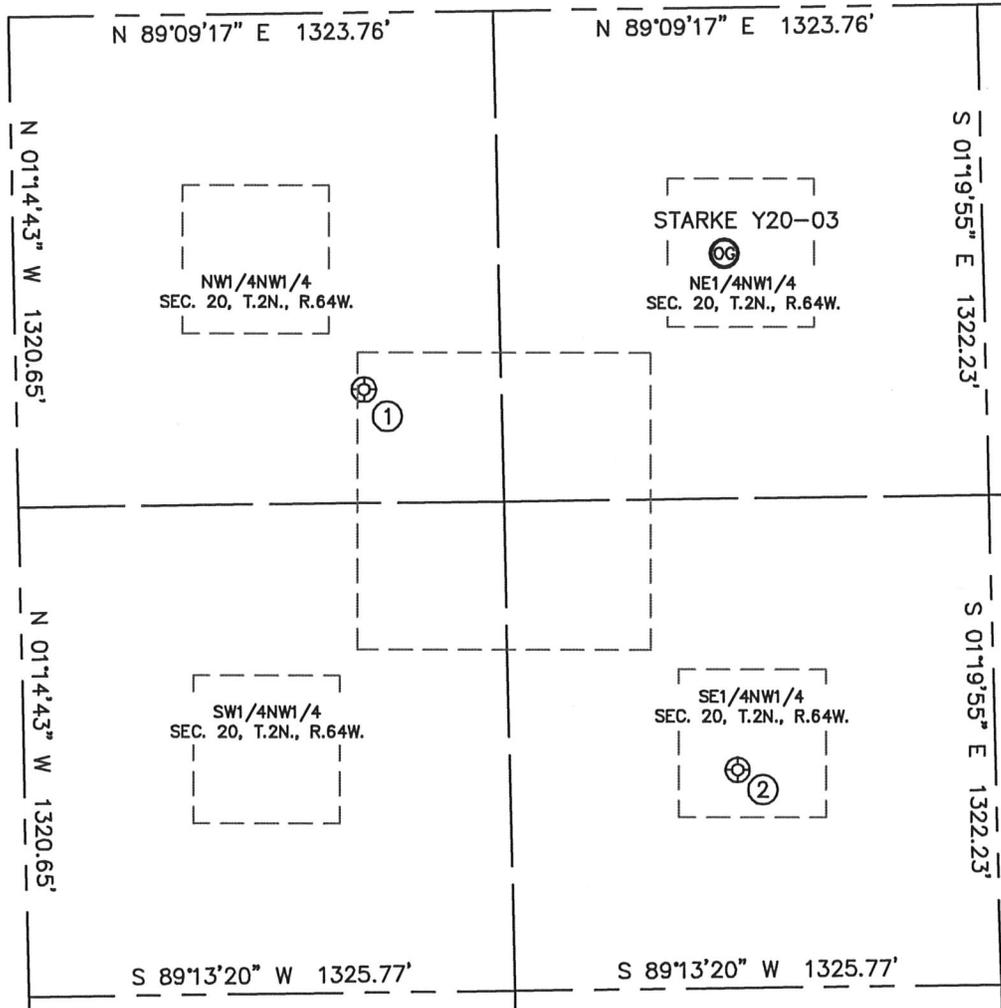

①

FOY 1  
NW1/4NW1/4  
1016' FNL  
950' FWL  
LAT-40.12841°N  
LONG-104.58130°W  
PDOP: 1.8  
ELEV: 4915'

②

FOY Y 20-6  
SE1/4NW1/4  
2055' FNL  
1946' FWL  
LAT-40.12557°N  
LONG-104.57769°W  
PDOP: 2.5  
ELEV: 4921'

