


Lat40°, LLC 1635 Foxtrail Drive, Suite 325 Loveland, CO 80538

# WELL LOCATION CERTIFICATE


THIS MAP DOES NOT REPRESENT A BOUNDARY SURVEY

SECTION: 17  
TOWNSHIP: 2N  
RANGE: 64W

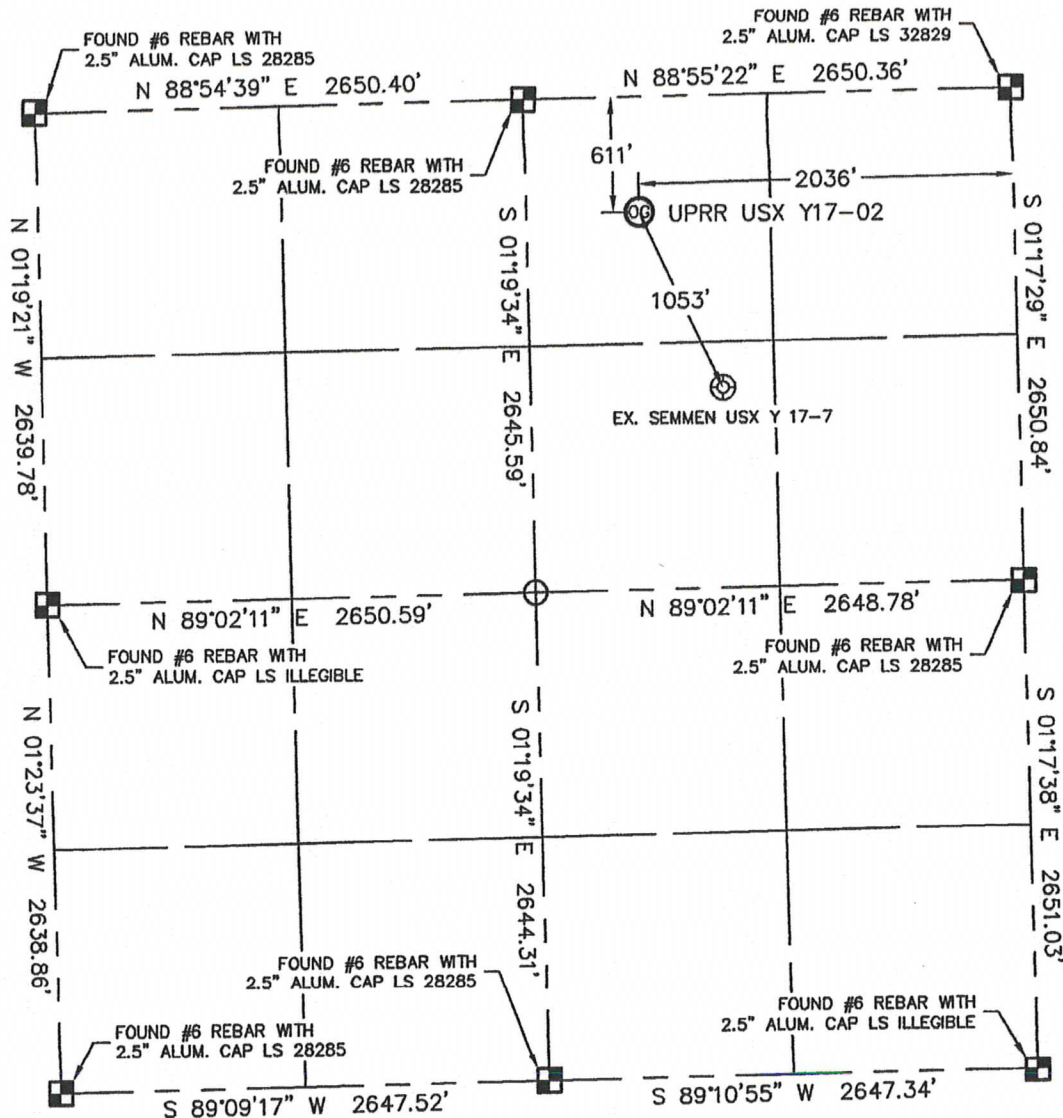

In accordance with a request from CJ PIETRI with Noble Energy Inc. Lat40°, LLC has determined the surface location of the UPRR USX Y17-02 to be 611' from the NORTH line and 2036' from the EAST line as measured at right angles from the section lines of Section 17, Township 2 North, Range 64 West of the Sixth Principal Meridian, County of Weld, State of Colorado.

I hereby state that this Well Location Certificate was prepared by me, or under my direct supervision, that the fieldwork was completed on 12/28/10, for and on behalf of Noble Energy Inc. That this is not a Land Survey Plat or an Improvement Survey Plat, and that it is not to be relied upon for establishment of fence, building, or other future improvement lines.

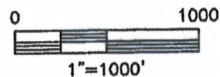

## NOTE:

- 1) Bearings shown are Grid Bearings of the Colorado State Plane Coordinate System, North Zone, North American Datum 1983/2007. The lineal dimensions as contained herein are based upon the "U.S. Survey Foot."
- 2) Ground elevations are based on an observed GPS elevation (NAVD 1988 DATUM).
- 3) NEAREST EXISTING WELL: SEMMEN USX Y 17-7, 1053'
- 4) IMPROVEMENTS: See LOCATION DRAWING for all visible improvements within 400' of disturbed area.
- 5) SURFACE USE: IRRIGATED CROP FIELD
- 6) INSTRUMENT OPERATOR: BRIAN BRINKMAN

## SURFACE LOCATION

LATITUDE: 40.14408°N  
LONGITUDE: 104.57329°W  
PDOP: 1.2  
ELEV: 4871'  
1/4, 1/4: NW1/4NE1/4  
NEAREST PROPERTY LINE: 495' NW



## NOTE

According to Colorado law, you must commence any legal action based upon any defect in this W.L.C. within three years after you discover such defect. In no event, may any action based upon any defect in this survey be commenced more than ten years after the date of the certificate shown hereon. (13-80-105 C.R.S.)

## LEGEND


- = ALIQUOT MONUMENT AS DESCRIBED
- = CALCULATED POSITION

Brian T. Brinkman—On behalf of Lat40°, LLC  
Colorado Licensed Professional  
Land Surveyor No. 38175 PROJECT#: 2010158

# SITE SKETCH

UPRR USX Y17-02

SECTION: 17  
TOWNSHIP: 2N  
RANGE: 64W

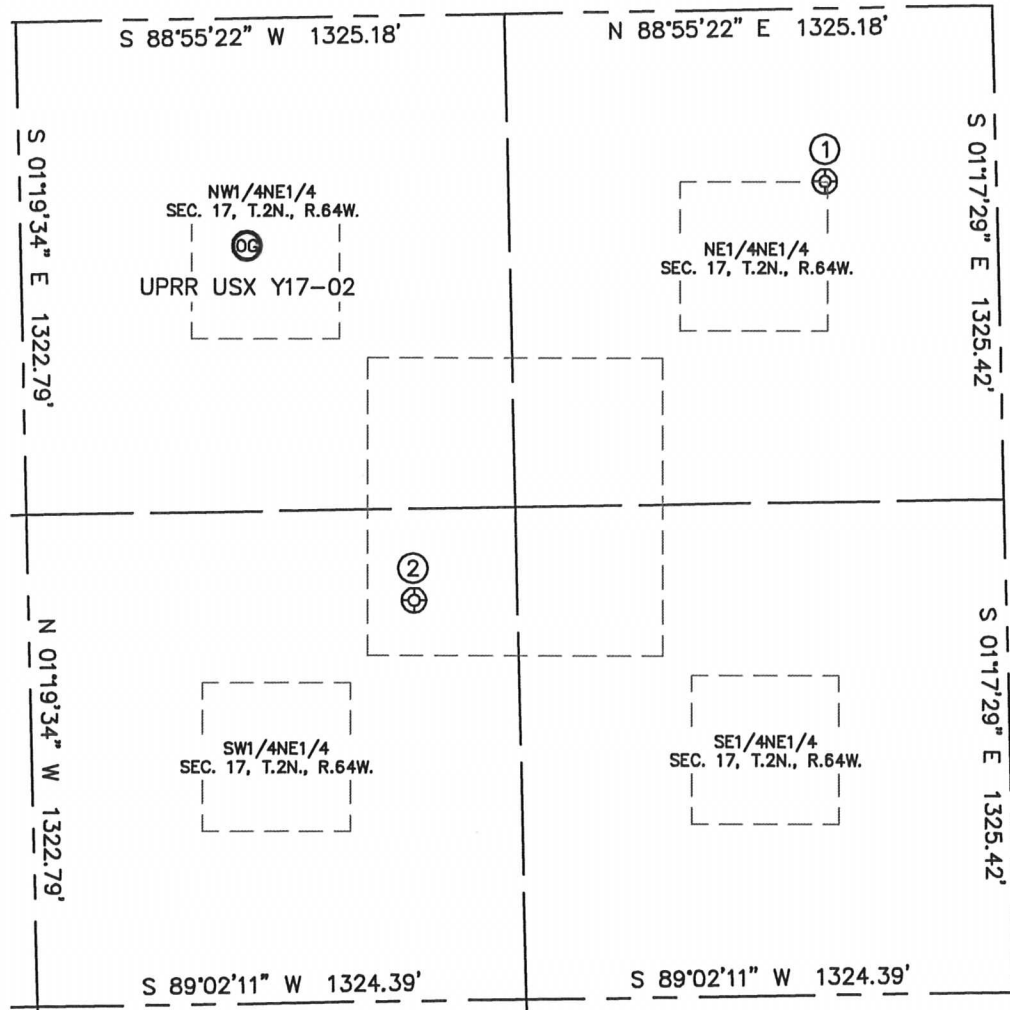

①

SLOAN 41-17  
NE1/4NE1/4  
465' FNL  
464' FEL  
LAT-40.14451°N  
LONG-104.56767°W  
PDOP: 1.4  
ELEV: 4877'

②

SEMMENT USX Y 17-7  
SW1/4NE1/4  
1570' FNL  
1604' FEL  
LAT-40.14145°N  
LONG-104.57170°W  
PDOP: 1.6  
ELEV: 4875'

