

CURRENT WELLBORE DIAGRAM

1200' FNL & 1000' FWL

Operator: EnCana Oil & Gas (USA) Inc.
Well Name: Hell's Hole 9120
Lease Number: COC62567
Location: NWNW Sec. 13-T2S-R104W
Field: Hell's Hole
County, State: Rio Blanco County, CO
API Number: 05-103-09971
Diagram Date: 08/30/2010

Well History

Spud Date: 09/28/1999
Mancos Recomplete: 08/13/2010

9-5/8" 36# K55 STC surface csg
set @ 833'; cemented w/
455 sx cmt to surface
Hole Size 12-1/4"


Tubing Detail:
129jts 2-7/8 J55 tbg, 2-7/8" PSN
EOT 4379'

Miller RBP 4.641" OD 10K
@ 4680' (12/10/2010)

Squeeze perms" 6106'

CICR @ 6820' w/ cmt cap @ 6714'

5-1/2" 17# N80 LTC prod csg
set @ 7918' cemented w/ 1135 sx
Hole Size 7-7/8"

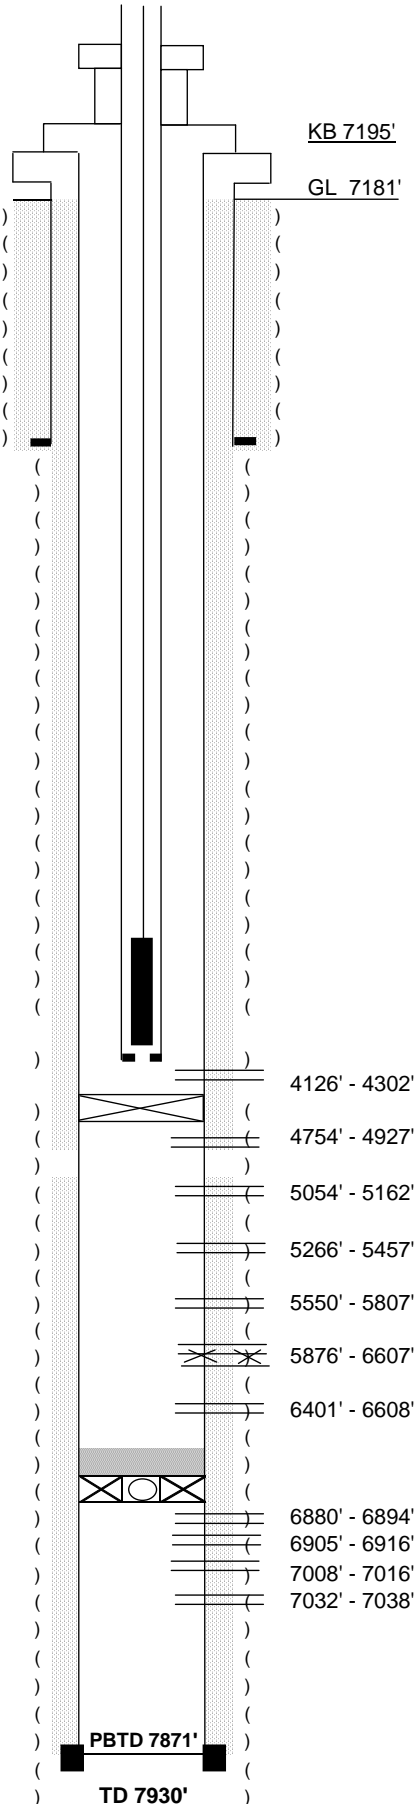

PBTD 7871'

TD 7930'